


T.1N.R.4W.W.M.

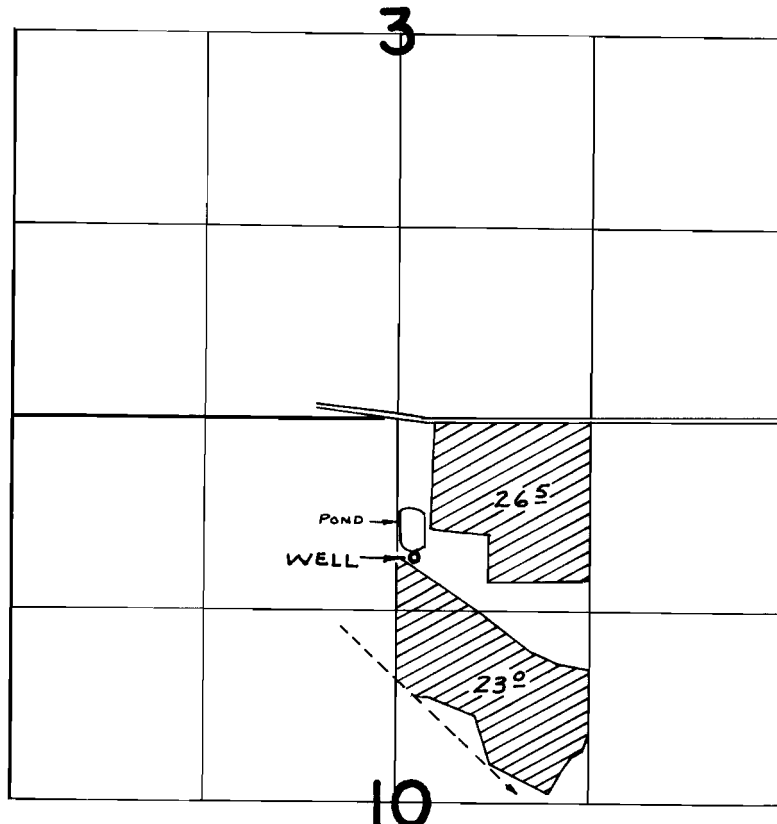

WELL LOC: 940' S. & 120' E. FROM N $\frac{1}{4}$ COR. SEC. 10

FINAL PROOF SURVEY UNDER

Application No. ~~G-5289~~ Permit No. ~~G-5025~~
IN NAME OF

MILTON J. & LORNA CLINTON

Surveyed NOV. 7, 1974, by R. MUCKEN