




T.1S. R.3W. W.M.

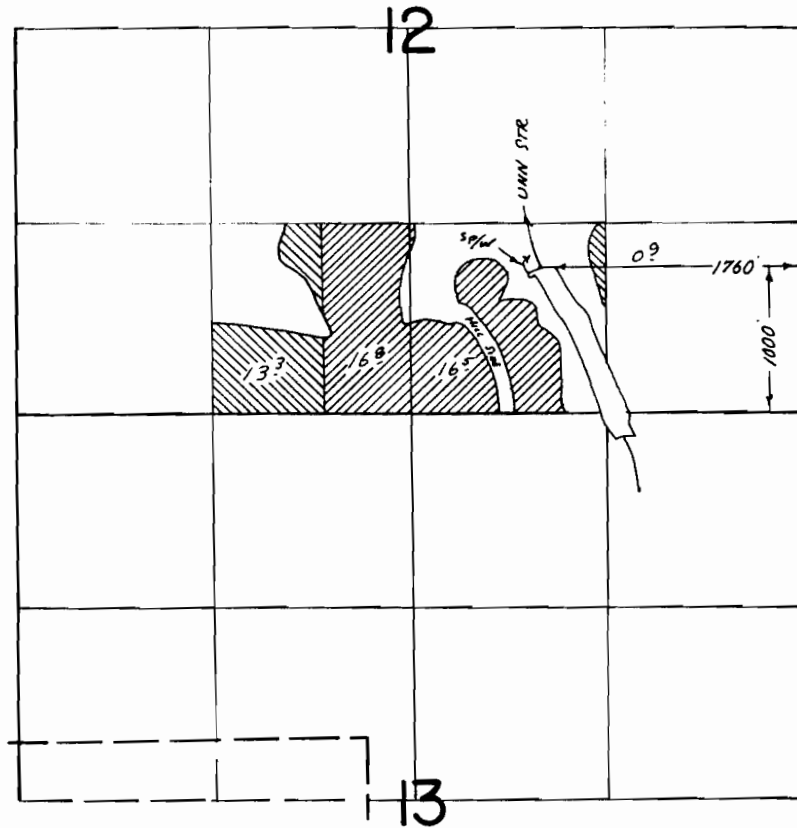

 Primary
 Supplemental

FINAL PROOF SURVEY
UNDER

R-43701 R-5458
Application No. ...43702 Permit No. ...34278
IN NAME OF

.....
JEAN C. JENKINS
.....

Surveyed Sep...4.. 1974., by R.G. MUCKEN