


T.6S., R.1E., W.M.

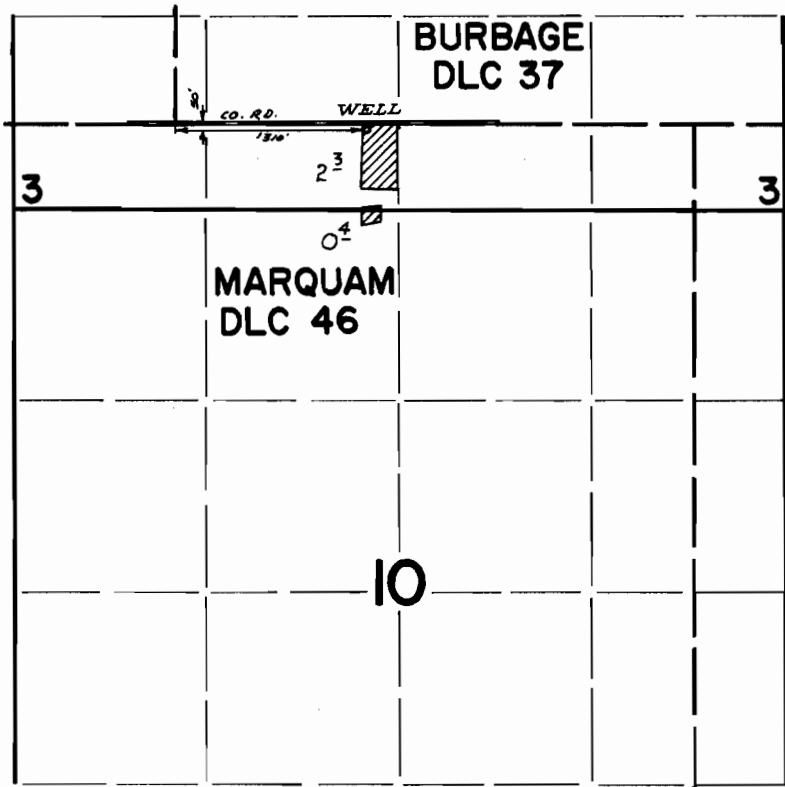

**FINAL PROOF SURVEY**  
UNDER

Application No. G-3996 Permit No. G-3750  
IN NAME OF

MILDRED GLEE AND GEORGE W. CLARK

Surveyed Sept. 20 1974, by David Norby