


T.3S.R.1W.W.M.

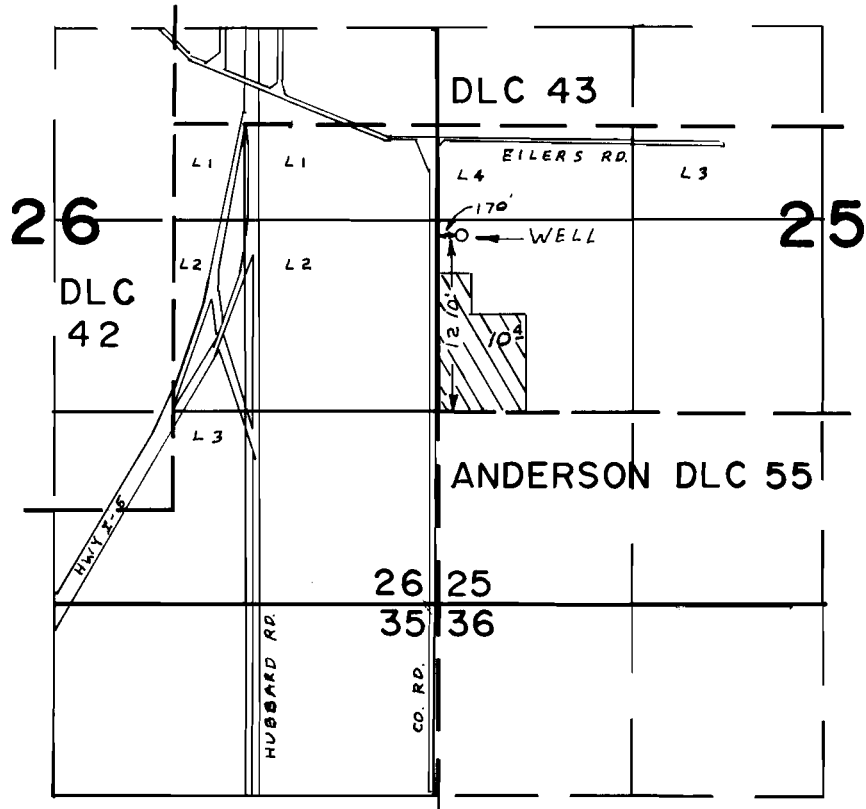

FINAL PROOF SURVEY UNDER

Application No. G-4524 Permit No. G-4262
IN NAME OF

PAUL MARVIN BROWN

Surveyed AUG 14 1974, by L.H. NUNN