


T.6S., R.2E., W.M.

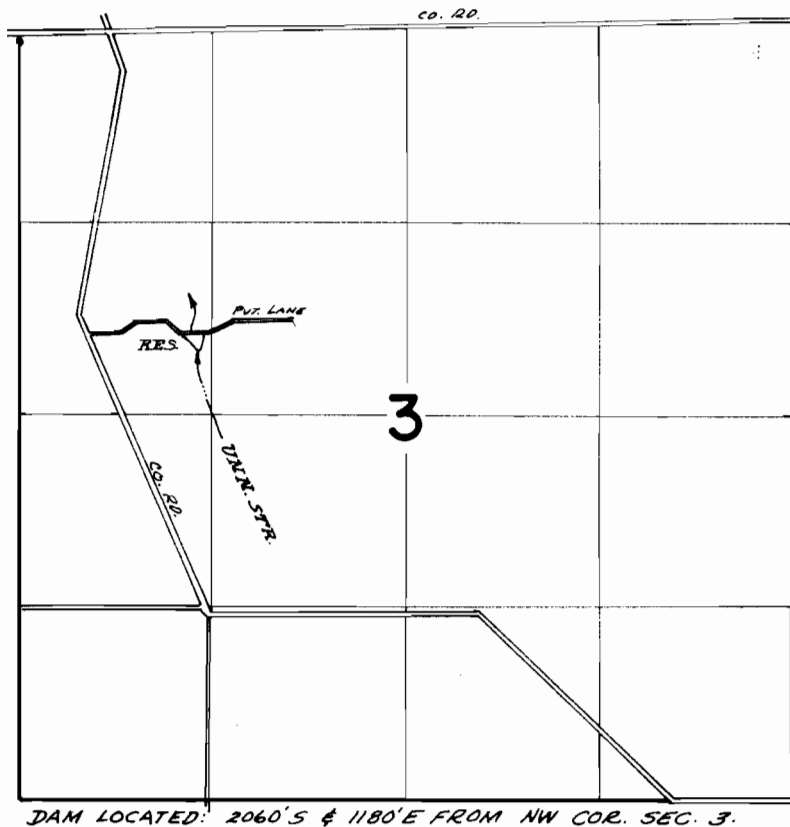

FINAL PROOF SURVEY
UNDER

Application No. R-47384 Permit No. R-5704
IN NAME OF

RICHARD W. AND JUDITH D. JONES

Surveyed Aug. 30 1974, by D. J. Jorby