


T.4S., R.1&2E., W.M.

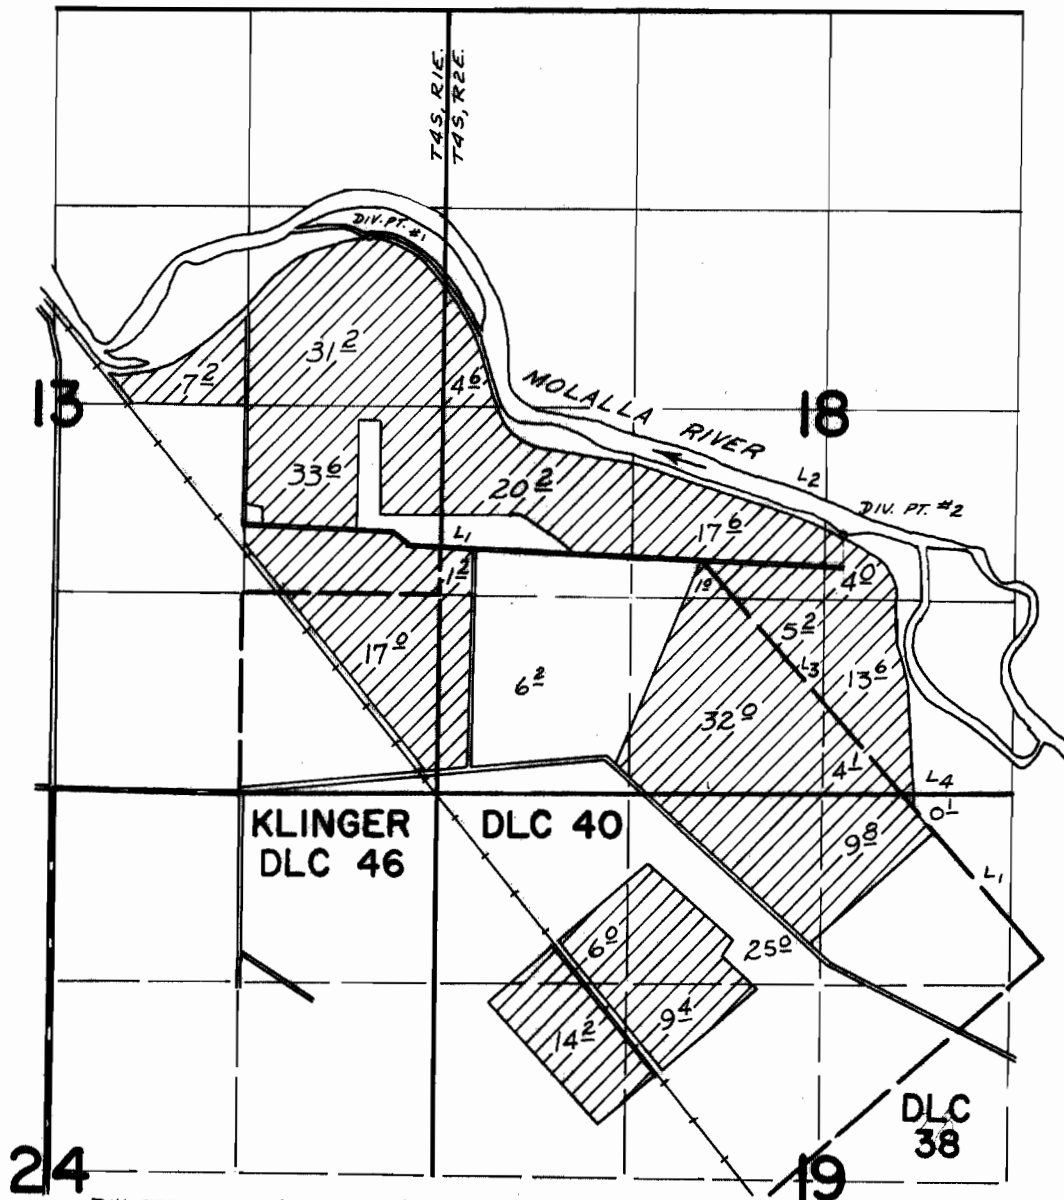

DIV. PTS. LOCATED: 1- 2200' N & 2300' W; 2- 180' N & 990' E BOTH FROM NLY NE COR. KLINGER DLC 40

FINAL PROOF SURVEY UNDER

Application No. 43683 Permit No. 32651
IN NAME OF

LOWELL BRUCE HEIN

Surveyed Sept. 6 1974, by D. Dorby