


T. 4 S. R. 1 E. W.M.

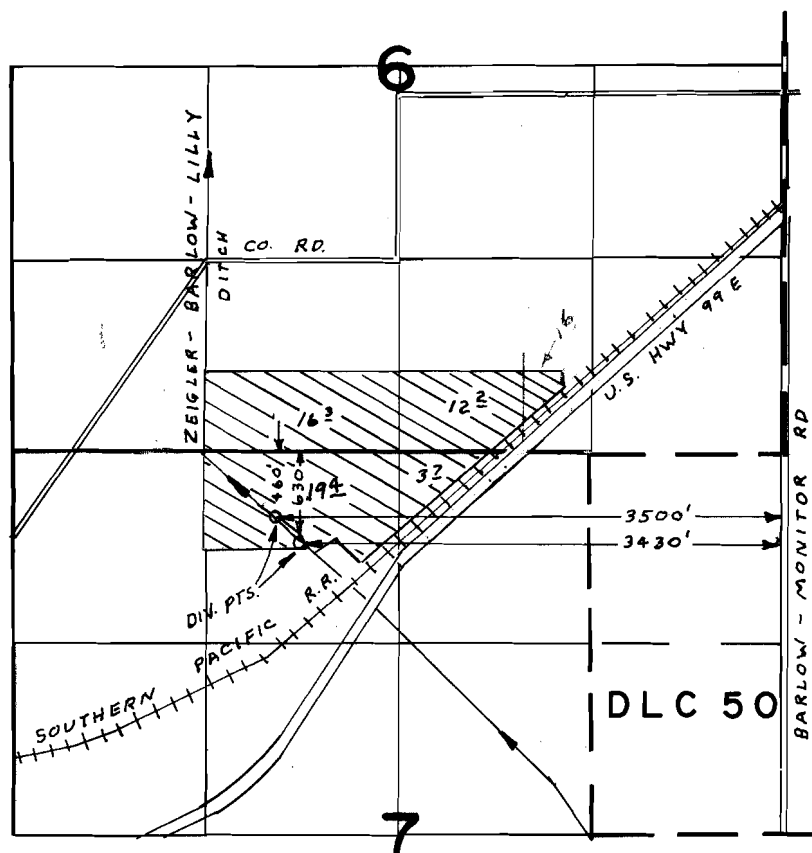

FINAL PROOF SURVEY UNDER

Application No. 44112 Permit No. 32951
IN NAME OF

CHESTER H. ROOKLIDGE - & DUANE & MARY E. DENNING

Surveyed NOV. 8 1974, by L. H. NUNN