


T.2S. R.2E. W.M.

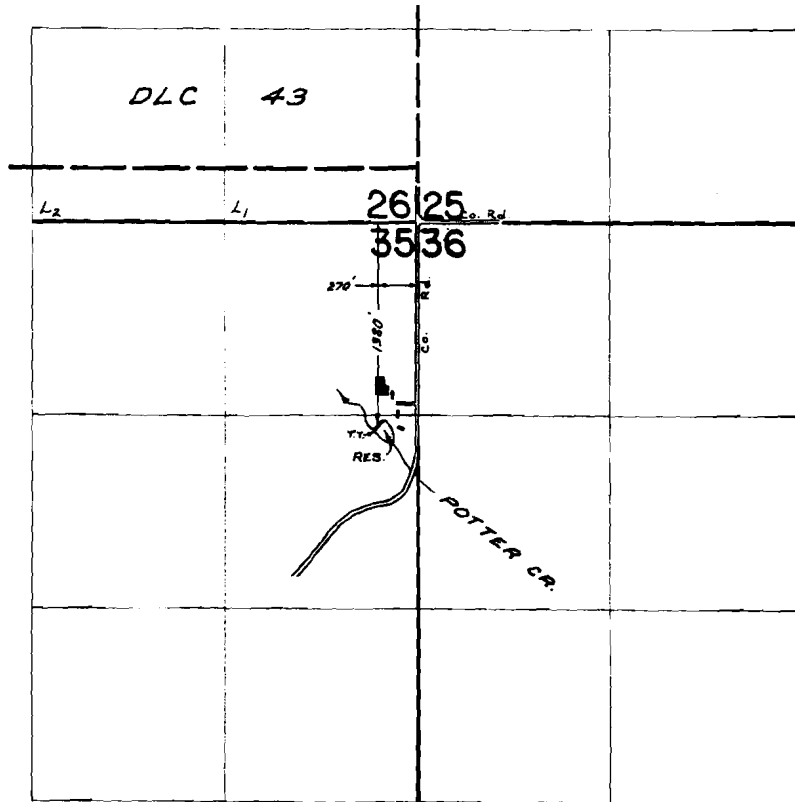

**FINAL PROOF SURVEY**  
UNDER

Application No. 45123 R-45480 Permit No. 34017 R-5392

IN NAME OF

FFADDCO

Surveyed OCT. 1, 1974, by L.E. GOULD