


T. 4 S. R. 3 E. W.M.

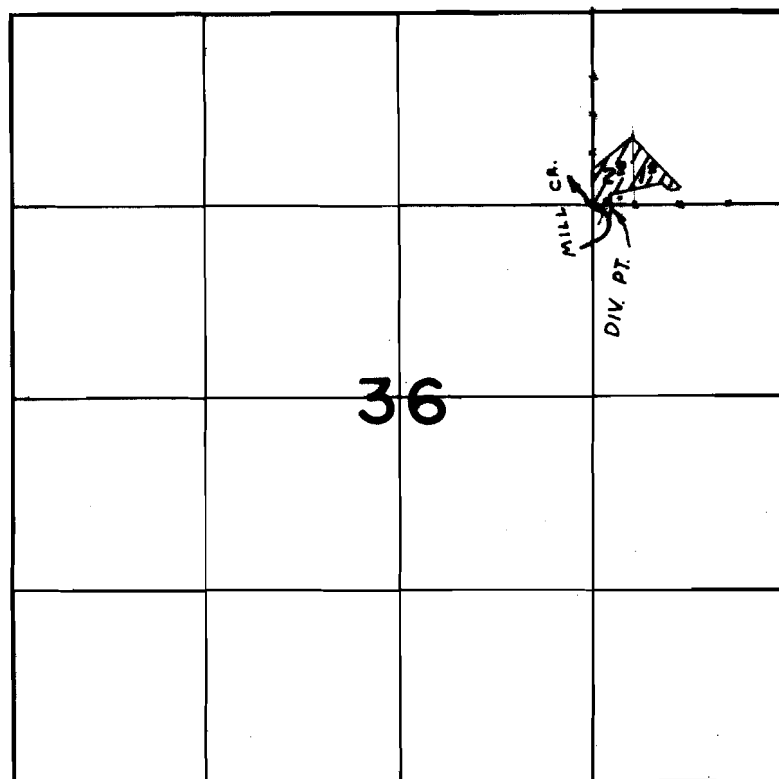

DIV. PT. LOC. 40'S. & 100' FROM SW COR OF
NE 1/4 NE 1/4, SEC. 36

FINAL PROOF SURVEY
UNDER

Application No. 47477... Permit No. 35125...
IN NAME OF

JOSEPH HERMAN STOCKER

Surveyed SEP. 26. 1974., by L.H. NUNN