


# T.3S. R.1W. W.M.

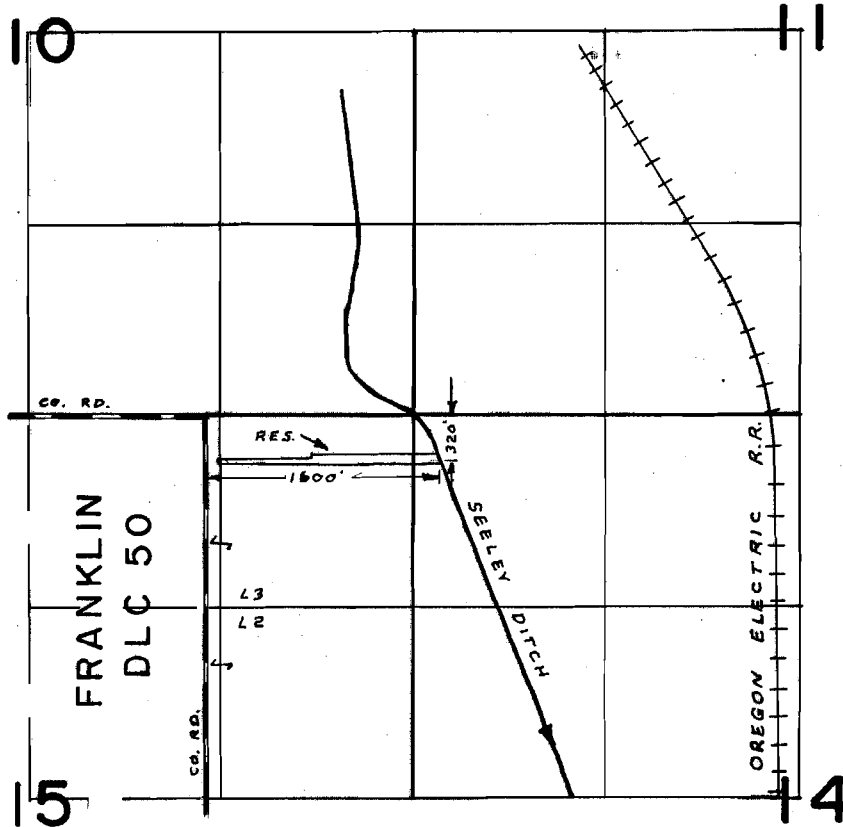

## FINAL PROOF SURVEY UNDER

R-49420                      R-6012  
Application No. 49421 Permit No. 37031  
IN NAME OF

EMERSON U. SIMS

Surveyed NOV. 8, 1974, by L.H. NUNN