


T.3S.R.1W.W.M.

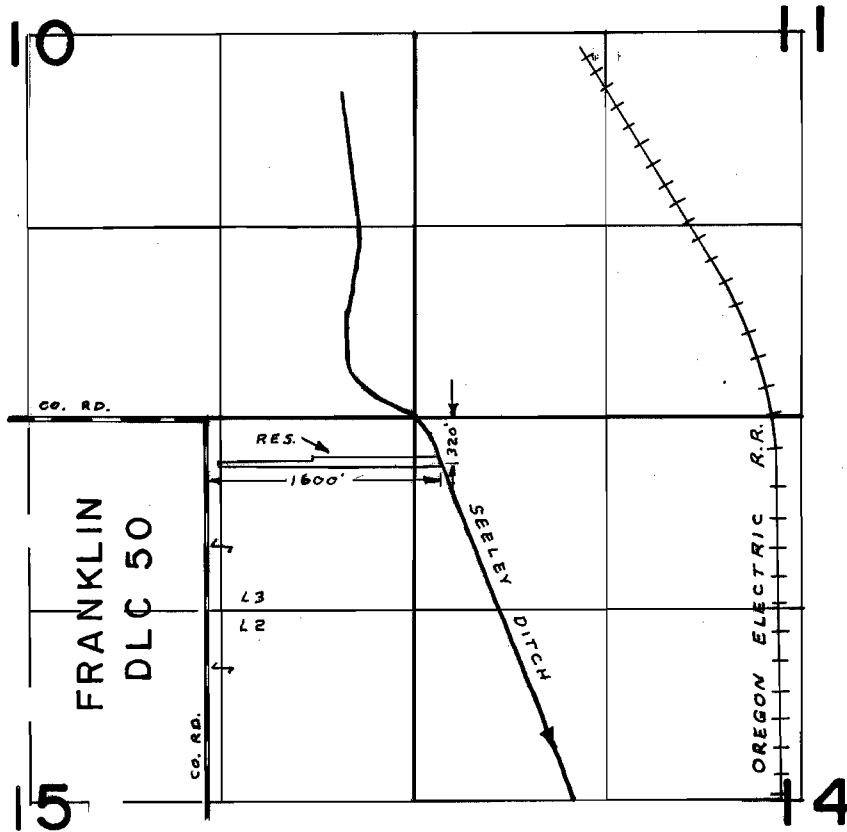

**FINAL PROOF SURVEY**  
UNDER

R-49420 R-6012  
Application No. 49421 Permit No. 37031  
IN NAME OF

EMERSON U. SIMS

Surveyed NOV. 8, 1974, by L. H. NUNN