


# T.5N.,R.7W.,W.M.

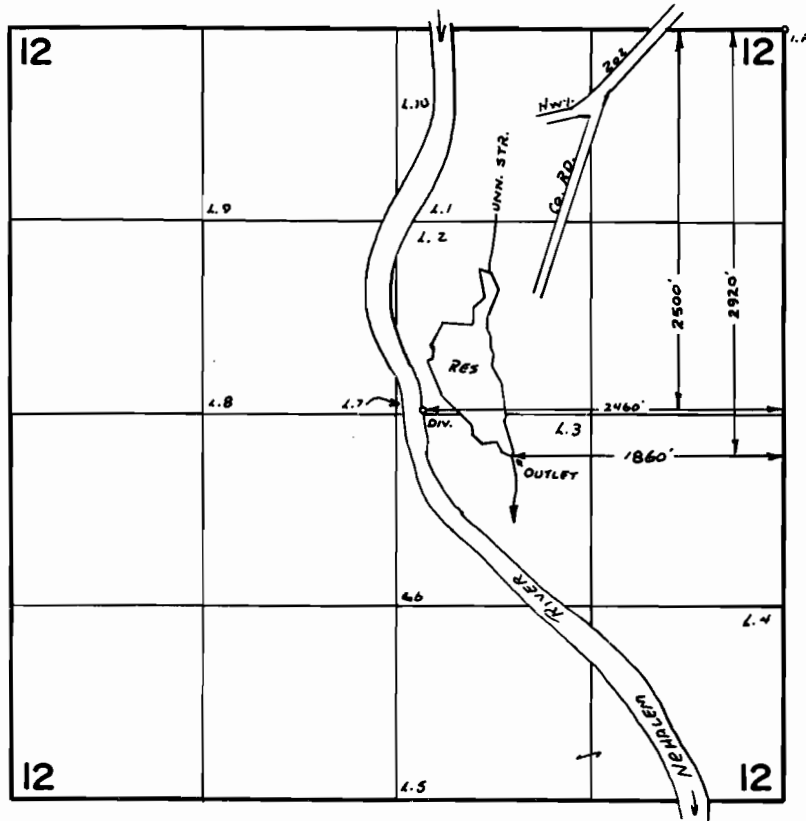

## FINAL PROOF SURVEY UNDER

R-44074                      R-5029  
Application No. 44189    Permit No. 32735  
IN NAME OF

SAMUEL H. LEE

Surveyed SEPT. 25 1975, by L. E. GAULO