


T.5N.,R.7W.,W.M.

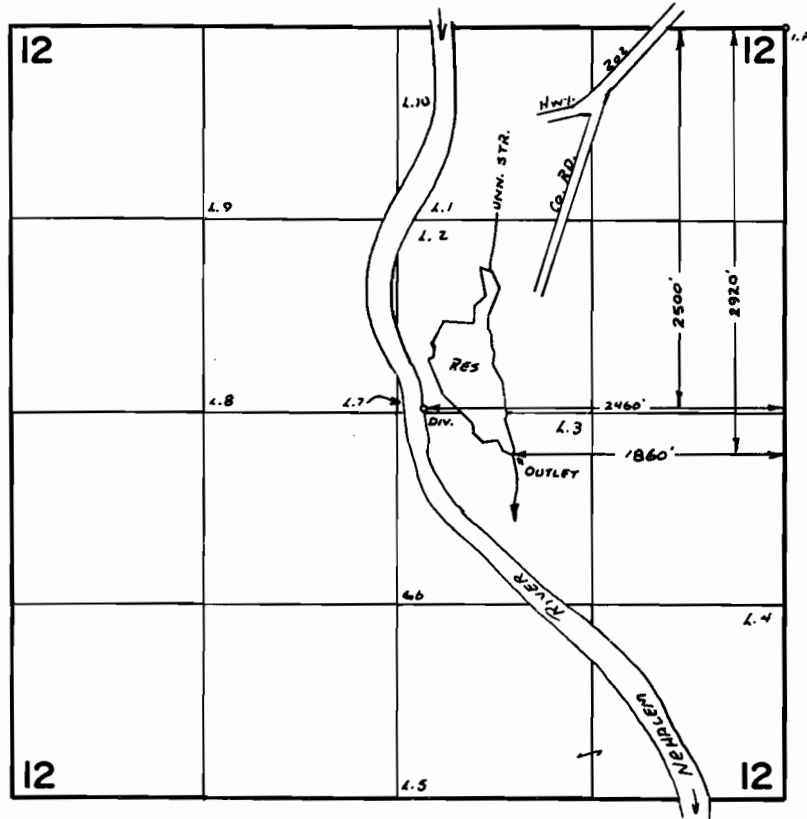

FINAL PROOF SURVEY UNDER

R-44074 R-5029
Application No. 44189 Permit No. 32735
IN NAME OF

SAMUEL H. LEE

Surveyed SEPT. 25 1975, by L. E. GAULD