


T. 5N. R. 4W. W.M.

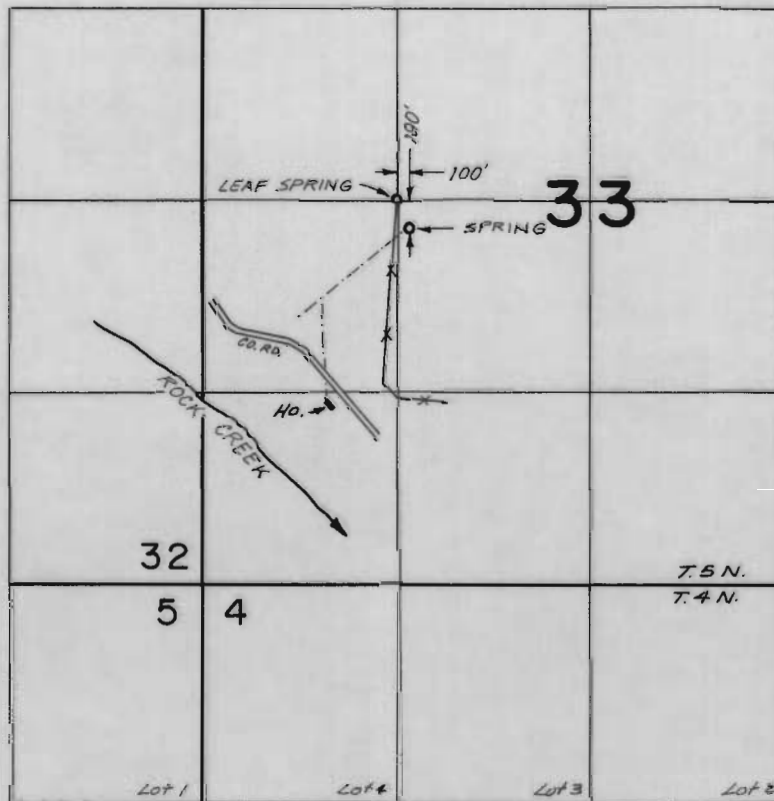

FINAL PROOF SURVEY
UNDER

Application No. 47836 Permit No. 35856
IN NAME OF

HAROLD BERGERSON

Surveyed AUGUST 13 1975, by R.G. MUCKEN