


T.23S.R.7W.W.M.

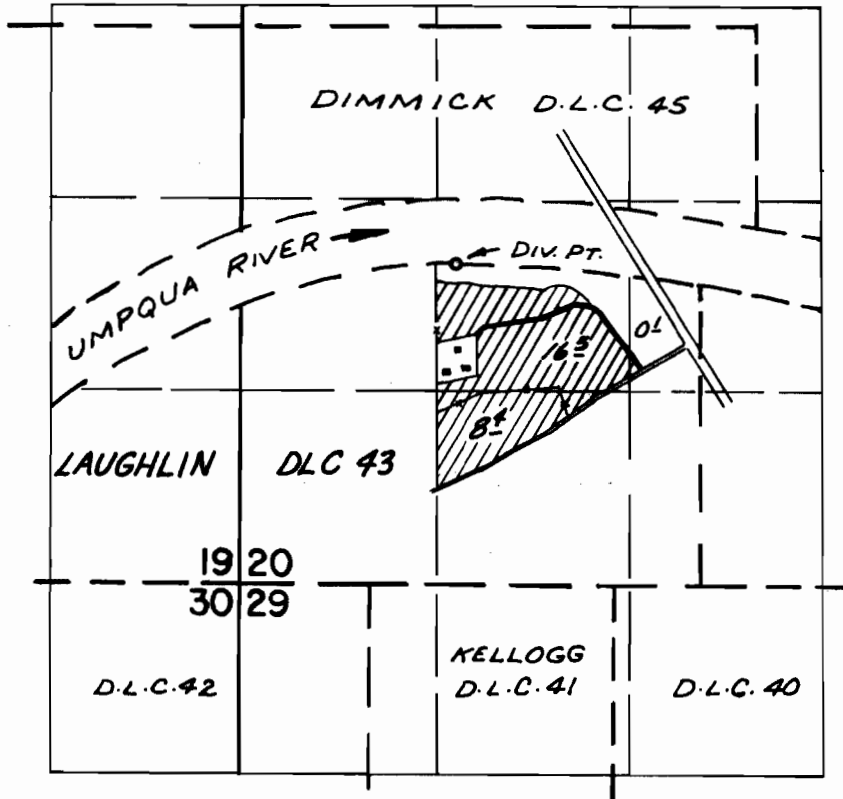

DIV. PT. LOC: 2200' N. & 600' E. FROM N.W. COR.
KELLOGG D.L.C. 41

FINAL PROOF SURVEY UNDER

Application No. 45104 Permit No. 33194
IN NAME OF

JAMES R. MADISON

Surveyed MAY 2, 1974, by R. MUCKEN