


T.23S., R.9W., W.M.

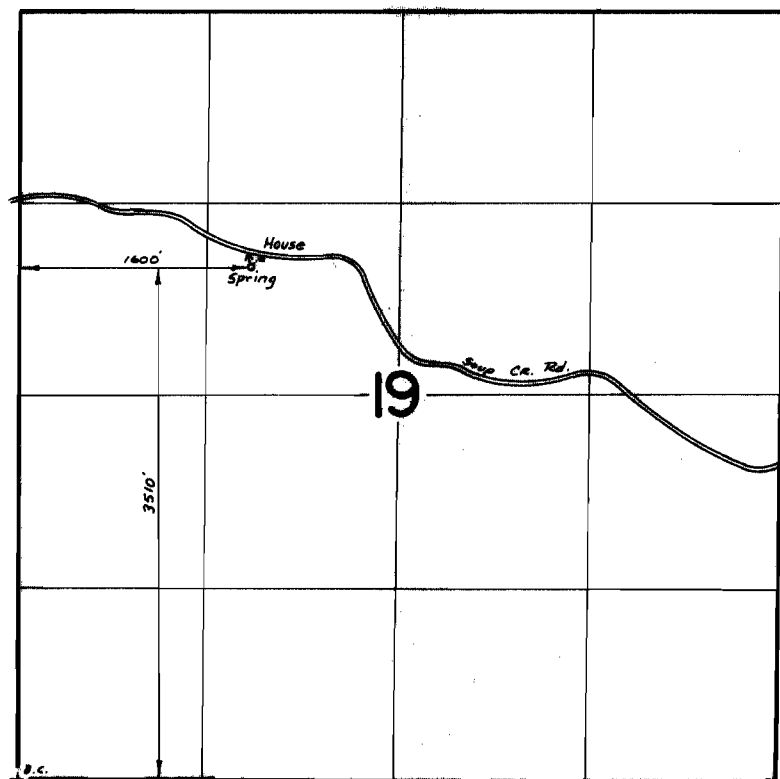

FINAL PROOF SURVEY
UNDER

Application No. 44940 Permit No. 33587
IN NAME OF

JOHN AND DOROTHY ANNIS

Surveyed July 23 1975, by D. Norby