


T.29S. R.5W. W.M.

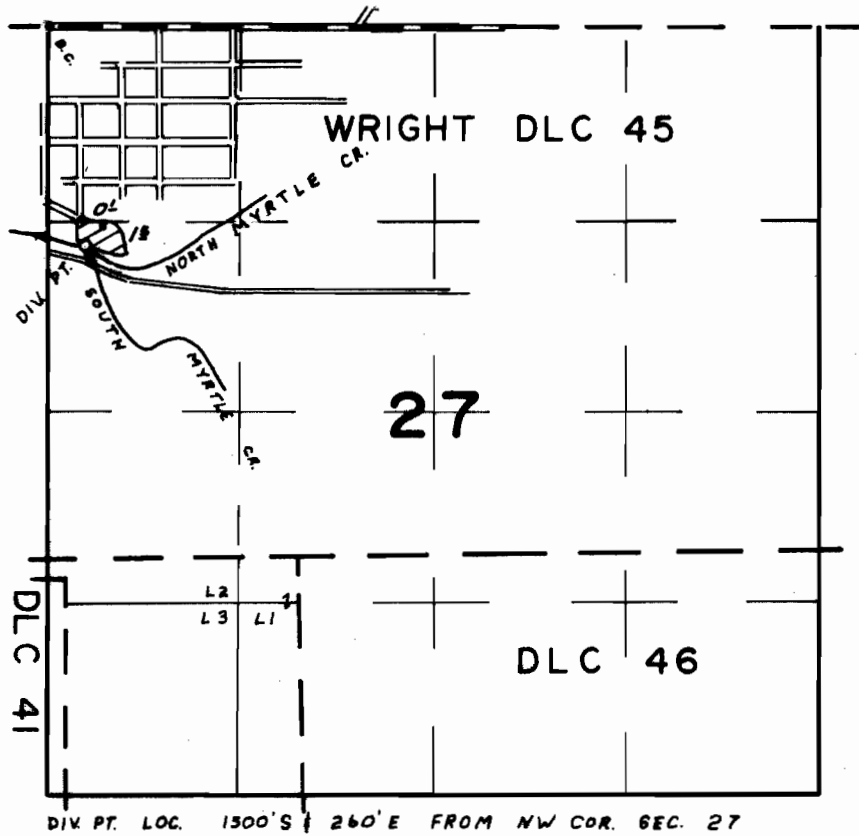

FINAL PROOF SURVEY
UNDER

Application No. 48547 Permit No. 36435
IN NAME OF

GERALD A. CLARK

Surveyed MAR. 25. 1975., by L.H. NUNN