


T. 34 S. R. 4 W. W.M.

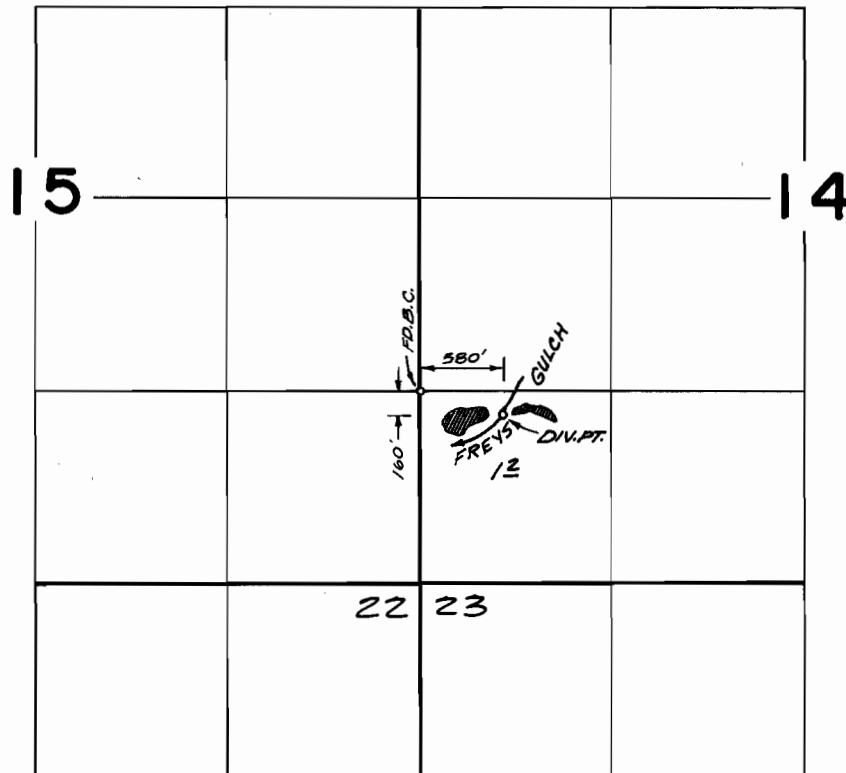

FINAL PROOF SURVEY
UNDER

Application No. 41644 Permit No. 31080
IN NAME OF

WILBUR E. HARRISON and/or RUANNA HARRISON

Surveyed JULY 24 1974, by D. NORBY