


T. 34 S. R. 4 W. W.M.

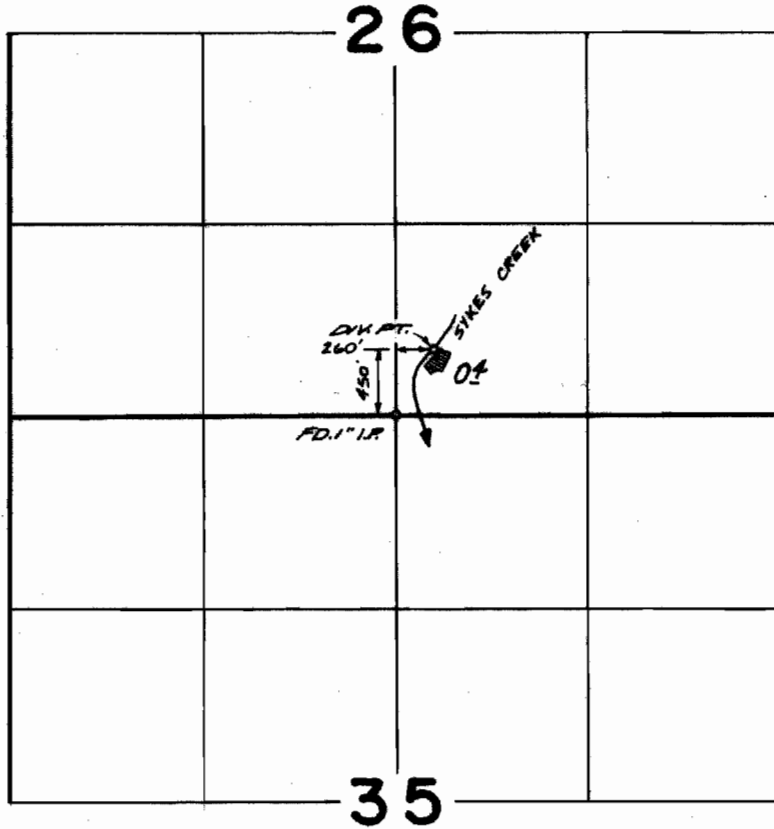

**FINAL PROOF SURVEY**  
UNDER

Application No. 47463 Permit No. 35555  
IN NAME OF

HARRISON C. BRADFORD

Surveyed JULY 24 1974 by D. NORBY