


T.15S. R.4&5W. W.M

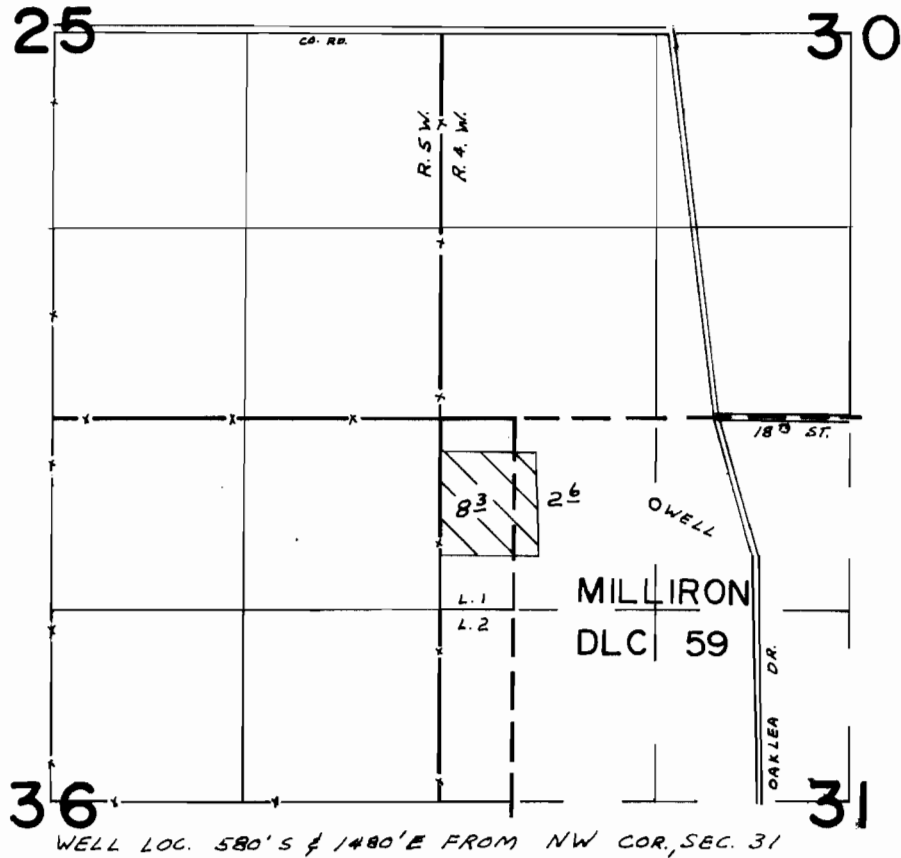

FINAL PROOF SURVEY UNDER

Application No. G-3728. Permit No. G-3464.
IN NAME OF

.....GARY G. & FRANCES E. HANSON.....

Surveyed SEP 23 1974, by L. TOLL.....
Inspected SEP 26 1975, by L.H. NUNN