


T.19S.R.1W.W.M.

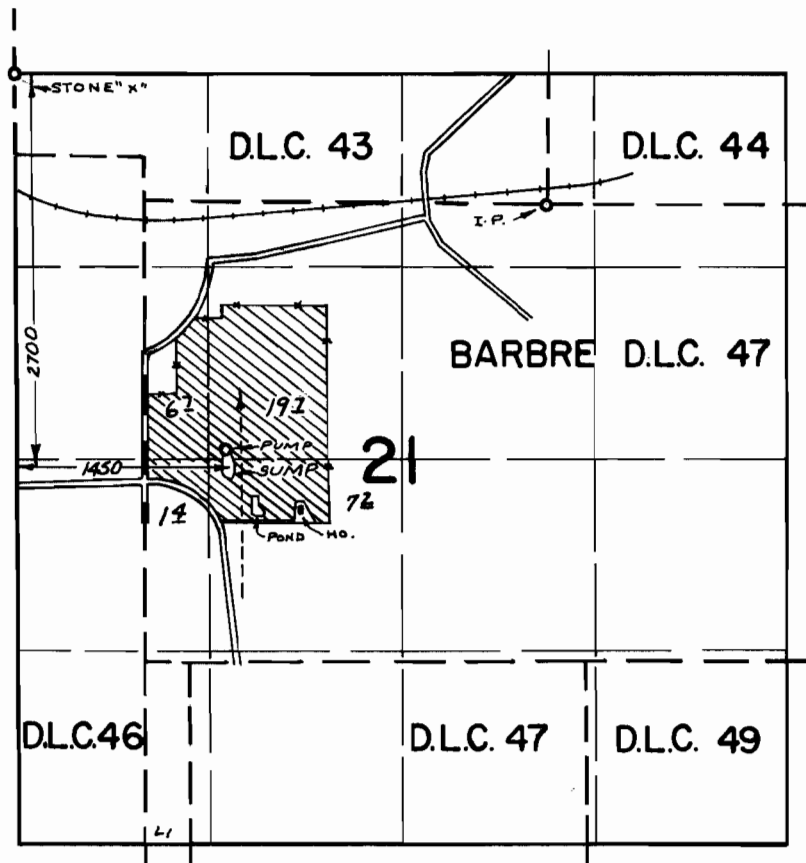

FINAL PROOF SURVEY
UNDER

Application No. G-4559 Permit No. G-4283
IN NAME OF

DAVID WENDALE TOOKER

Surveyed MAY 7, 1974, by R. MUCKEN