


T.16S. R.7W. W.M.

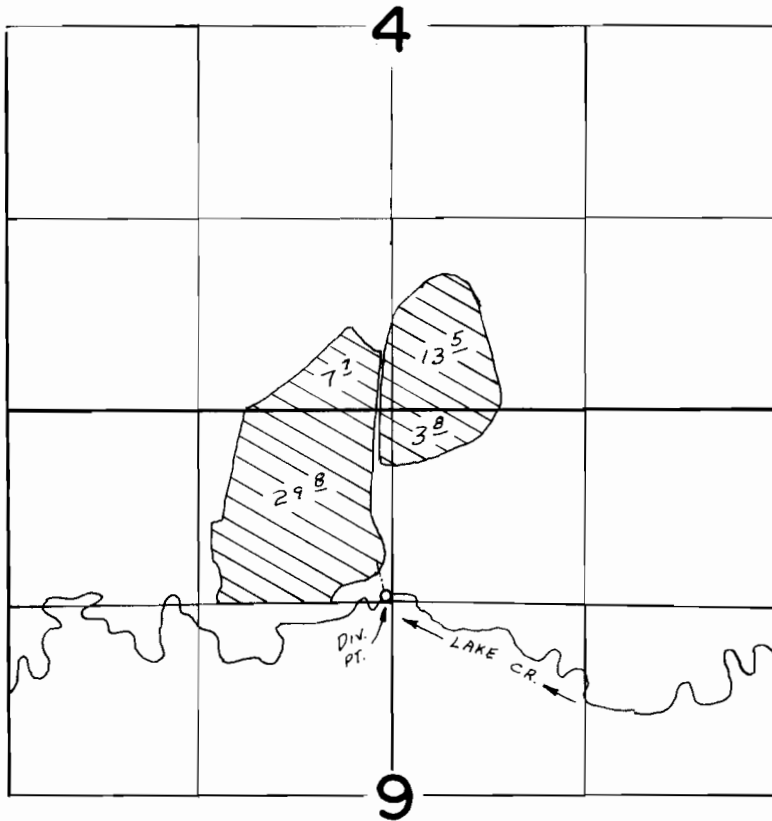

DIV. PT. LOC. 30' N & 50' W FROM SE COR. OF NE 1/4,
NW 1/4, SEC. 9, T.16S., R.7W., W.M.

FINAL PROOF SURVEY
UNDER

Application No. 42806 Permit No. 32002
IN NAME OF
WALDO CLAFLIN

Surveyed NOV 1 1974, by LH NUNN