
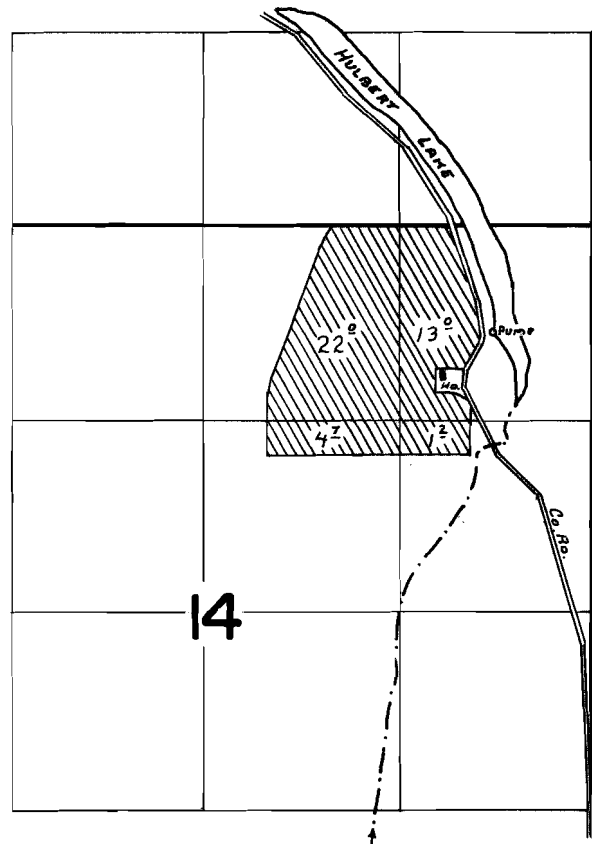


T.15S.,R.5W.,W.M.

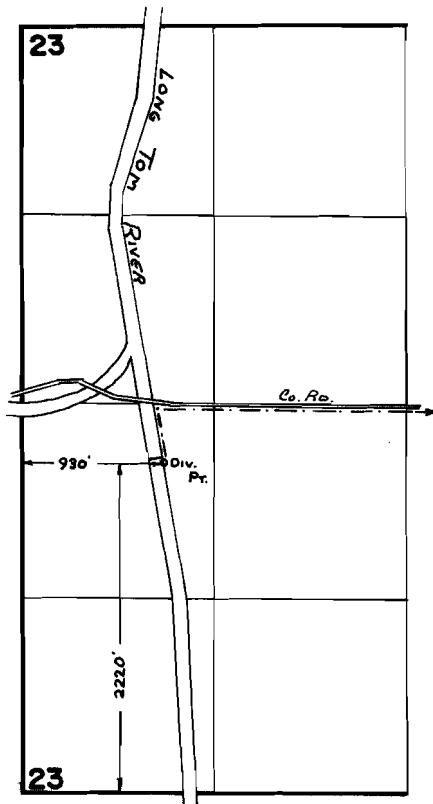

FINAL PROOF SURVEY
UNDER

Application No. 44578 Permit No. 33368
IN NAME OF

GILLIS AND LELA STROME

Surveyed SEPT. 24, 1974, by L. T. L.