


T.18S.R.2W.W.M.

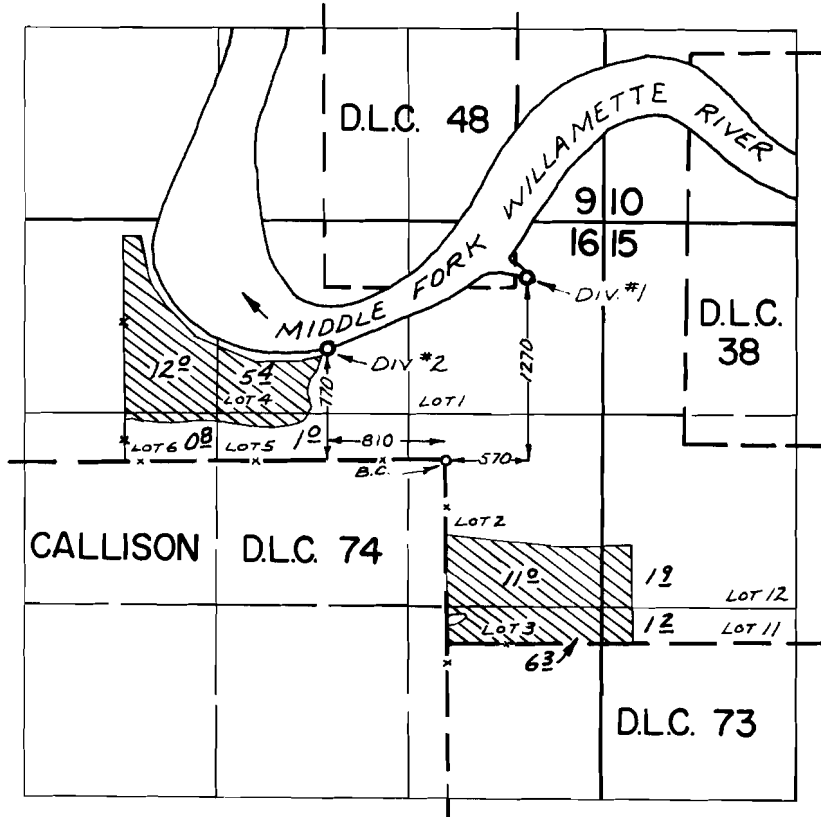

FINAL PROOF SURVEY UNDER

Application No. 45923 Permit No. 34310
IN NAME OF

LYMAN W. TINKER

Surveyed MAY 7 1974, by R. MUCKEN