


T.16S.R.5W.W.M.

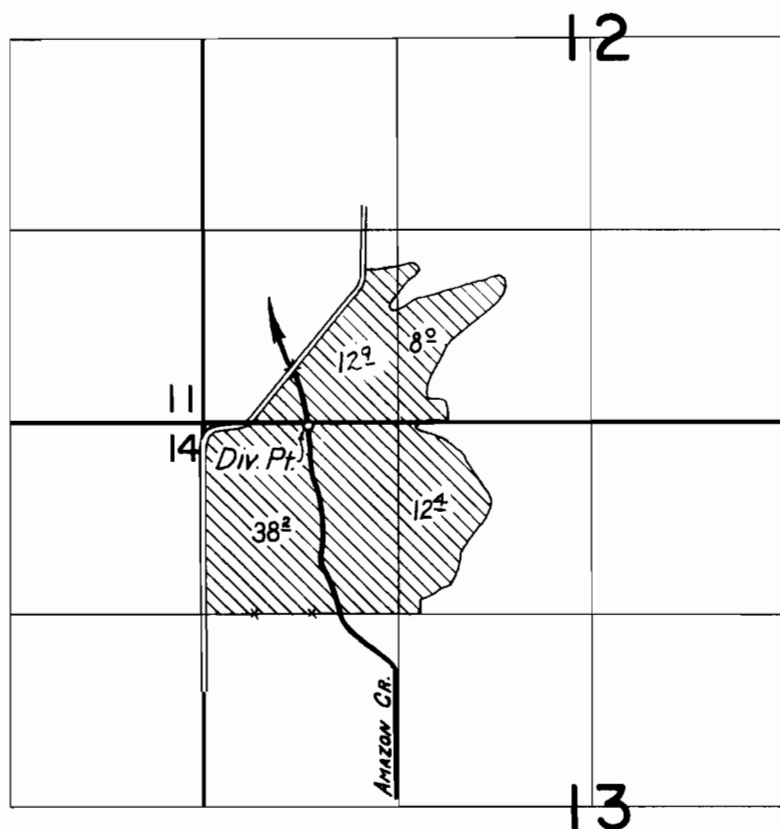

Div. Pt. Loc: 20' S. & 720' E. from NW. cor. Sec. 13

FINAL PROOF SURVEY UNDER

Application No. 46593 Permit No. 34820
IN NAME OF

EVERETT FALK

Surveyed JULY 27, 1974, by L.E. GOULD