


# T.16S.,R.2W.,W.M.

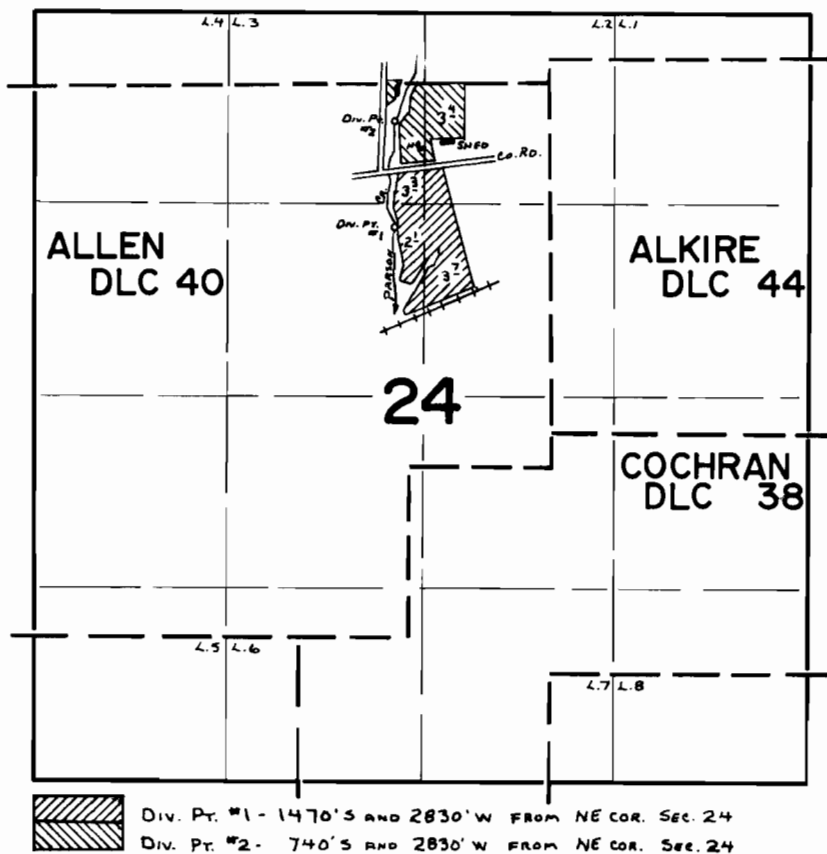

## FINAL PROOF SURVEY UNDER

Application No. 46773 Permit No. 34915  
IN NAME OF

NORMAN J. GREEN

Surveyed SEPT. 27 1974, by L. Toll