


T.16S.,R.2W.,W.M.

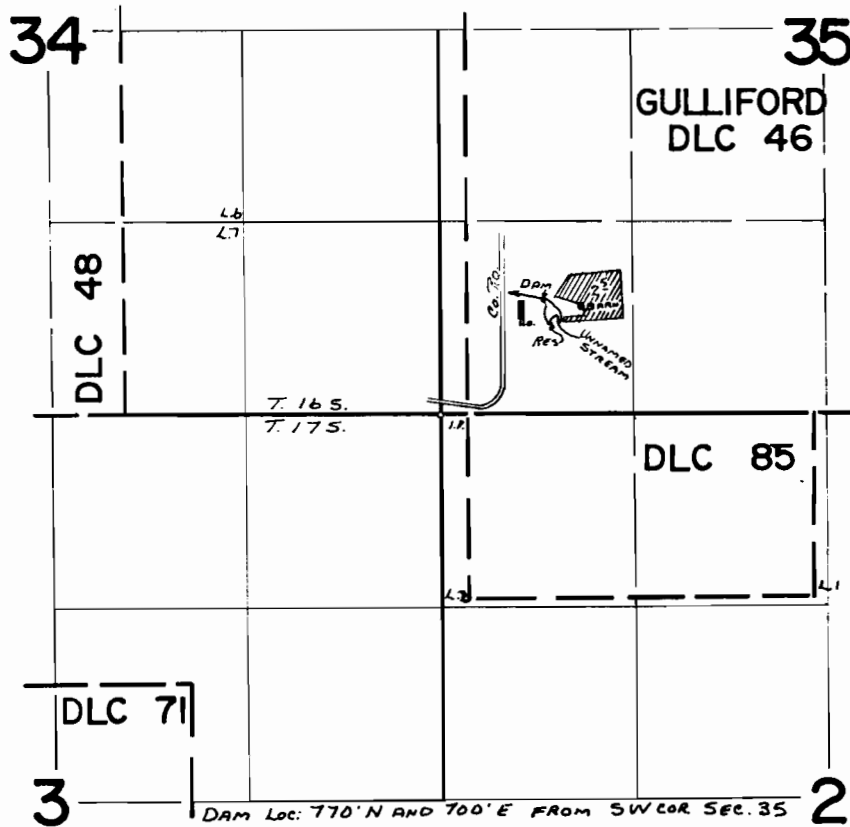

FINAL PROOF SURVEY

UNDER

Application No. **R-47157** Permit No. **R-5661**
47158 **35306**
 IN NAME OF

GEORGE R. SCHLEGEL

Surveyed SEPT. 25 1974, by L. TOLL.....