


T.16S.,R.2W.,W.M.

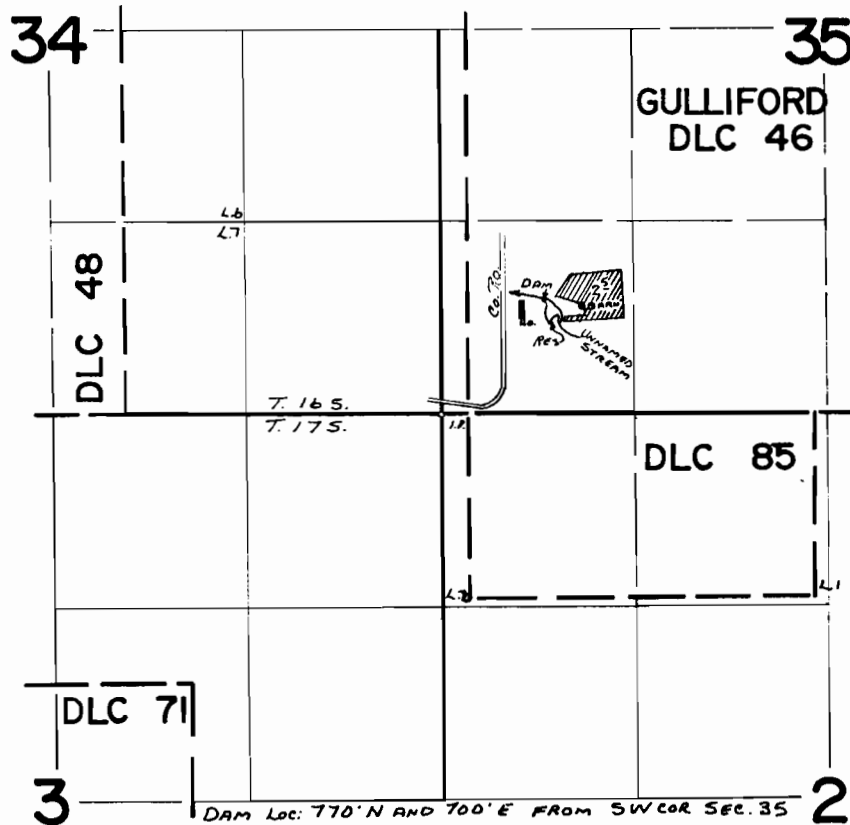

FINAL PROOF SURVEY
UNDER

R-47157 R-5661
Application No. 47158 Permit No. 35306
IN NAME OF

GEORGE R. SCHLEGEL

Surveyed SEPT. 25 1974, by L. Tolt