T.20S. R.3W. W.M.

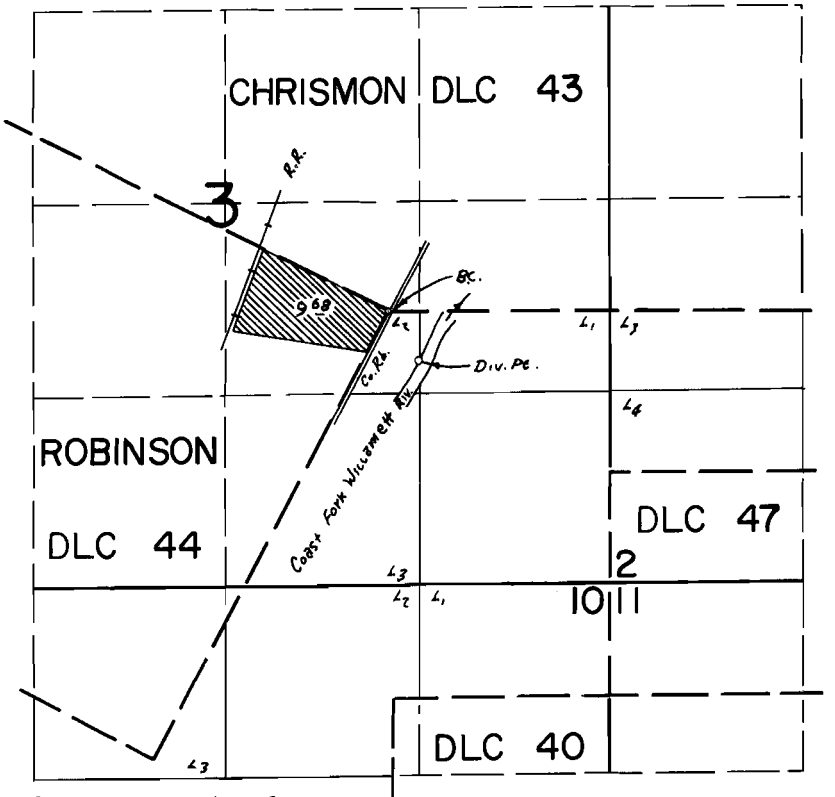

DIV. PT. LOC 350'S & 200'E FROM NE COR ROBINSON DLC 44

FINAL PROOF SURVEY
UNDER

Application No. 48260 Permit No. 35917
IN NAME OF

NORMAN GARRISON

Surveyed Aug. 13 1974, by D. M. NORBY

1974-B T.P.