


T.16S. R.6W. W. M.

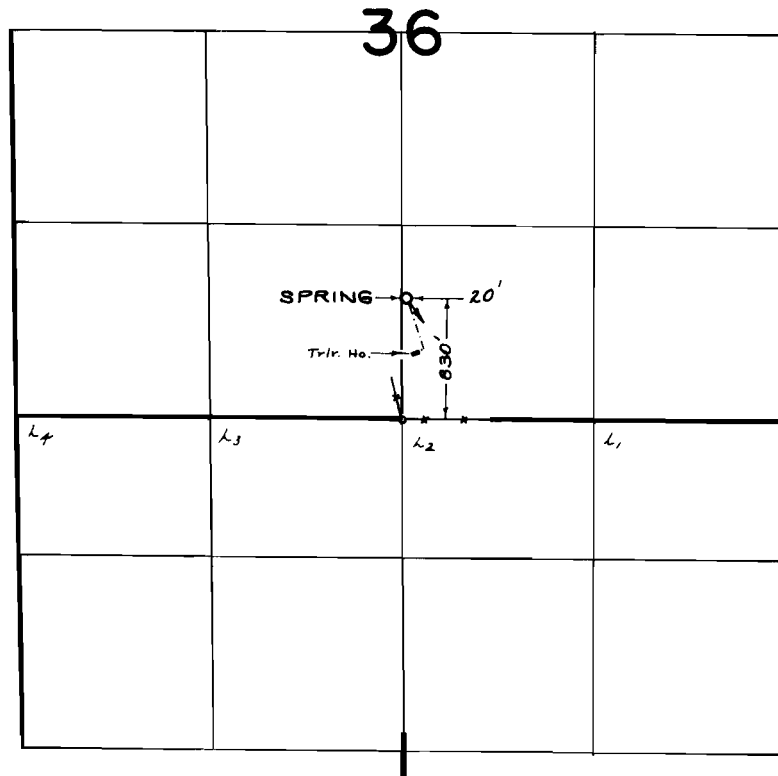

FINAL PROOF SURVEY
UNDER

Application No. 48056 Permit No. 36034
IN NAME OF

JOHN O. LARSON

Surveyed April 29, 1975, by R. MUCKEN