


T.IOS., R.IOW., W.M.

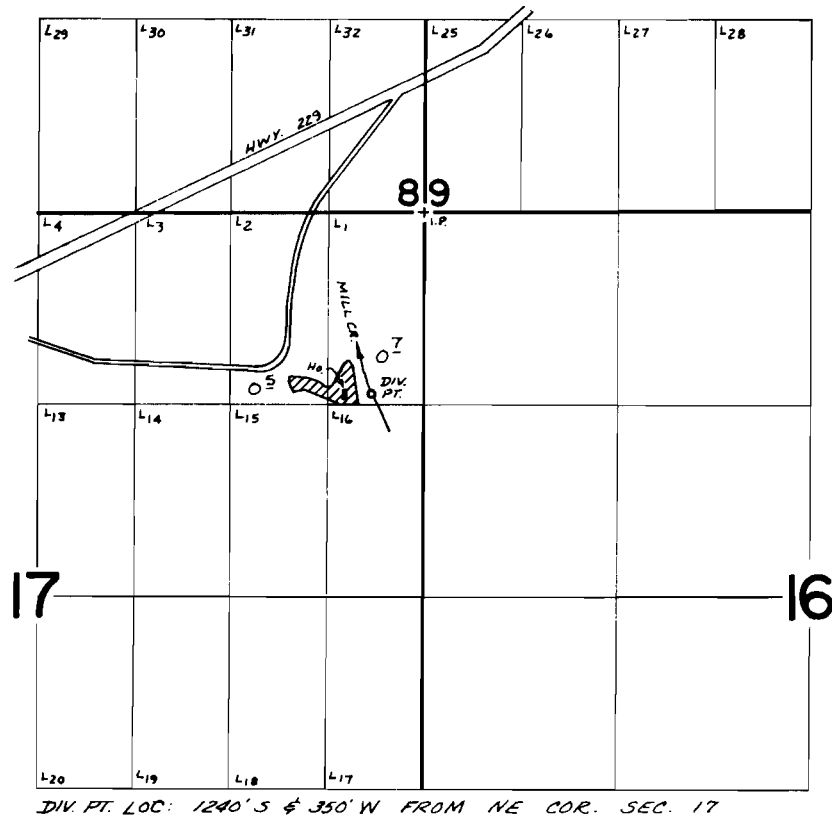

FINAL PROOF SURVEY
UNDER

Application No. 49361 Permit No. 37003
IN NAME OF

DuWAYNE L. ABRAHAMSON

Surveyed June 4 1975, by D. Norby