


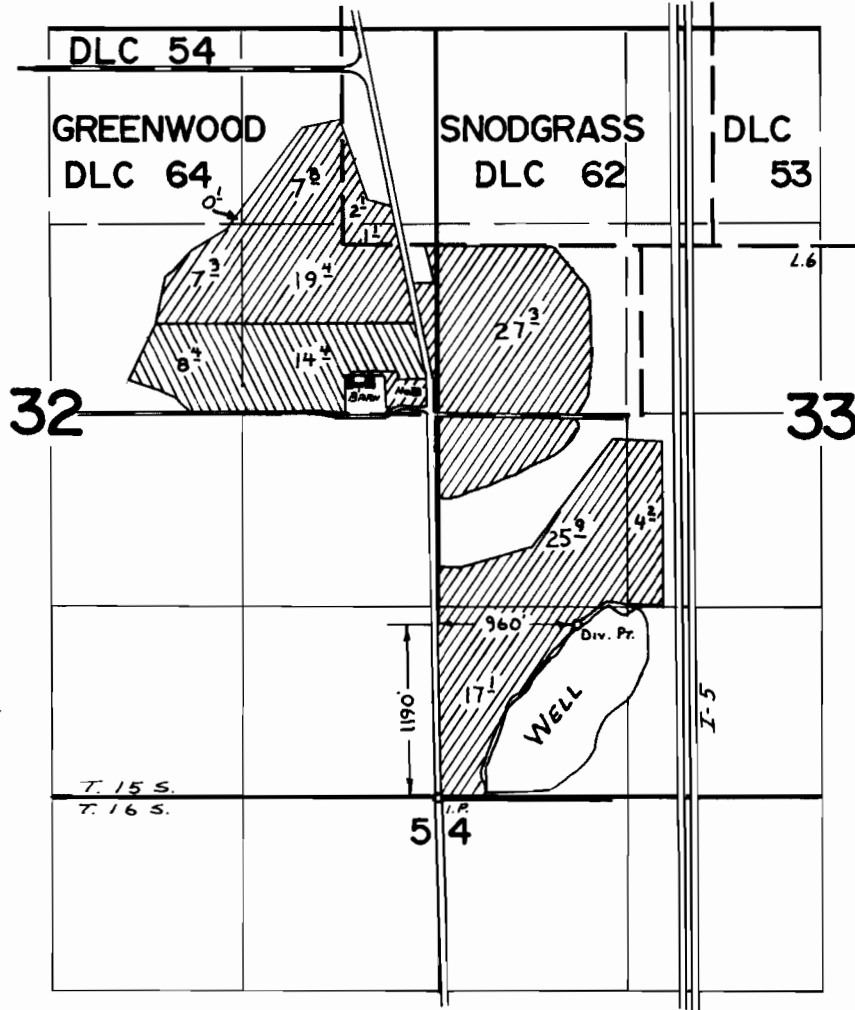

# T.15S.,R.3W.,W.M.



 PRIMARY IRRIGATION  
 SUPPLEMENTAL IRRIGATION

## FINAL PROOF SURVEY UNDER

Application No. G-4756 Permit No. G-4511  
IN NAME OF

C. DUDLEY MILLER

Surveyed OCT. 17, 1974, by L. TOLL