


T.11S., R.2W., W.M.

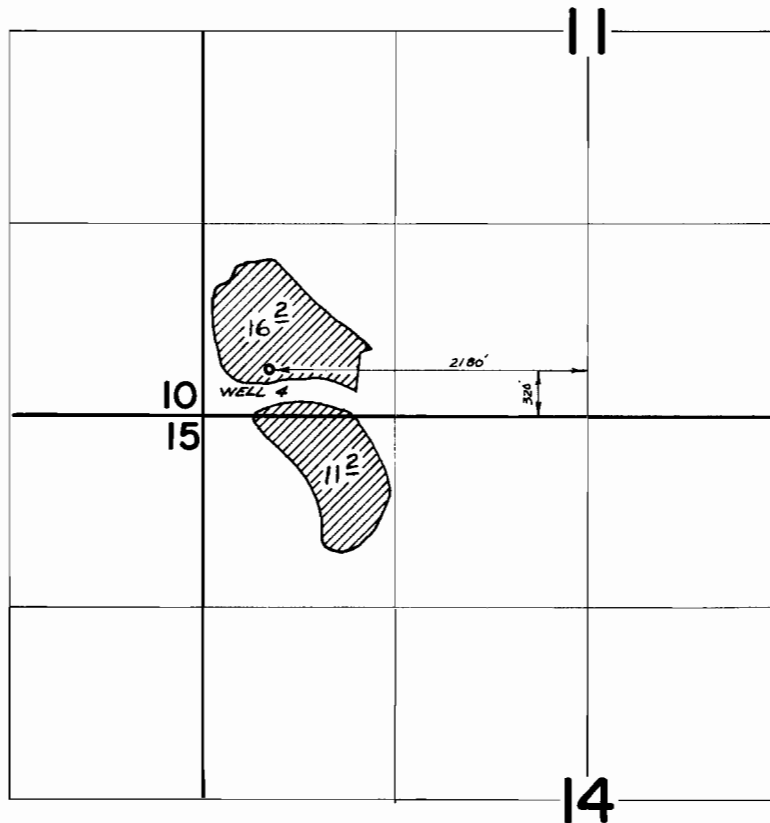

FINAL PROOF SURVEY UNDER

Application No. G-5153 Permit No. G-4885
IN NAME OF

VERNON AND HELEN SNODDY

Surveyed April 3 1974, by S.P. Applegate