


T.IOS., R.IW., W.M.

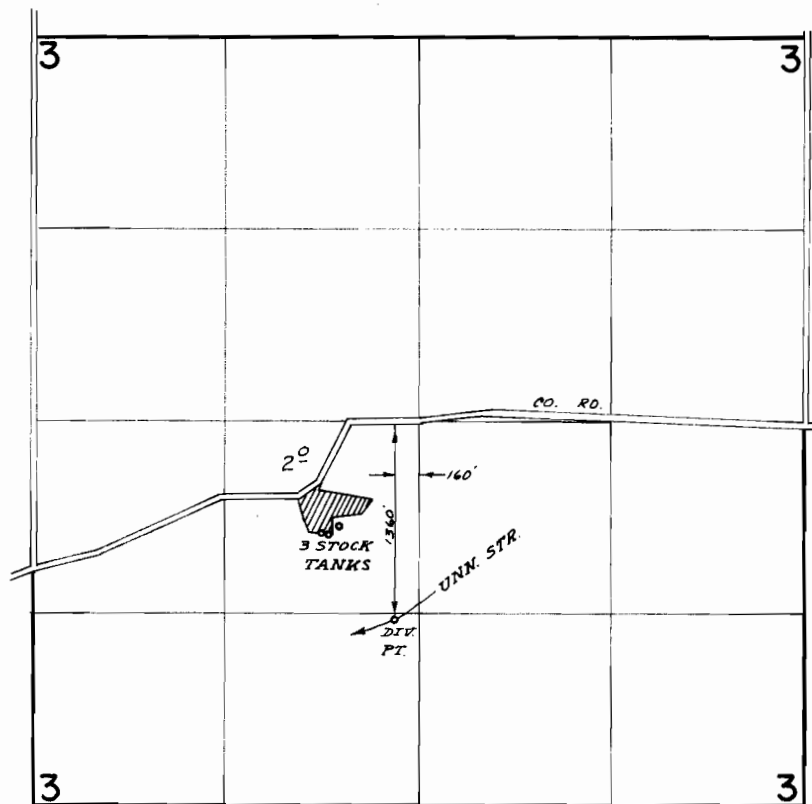

FINAL PROOF SURVEY
UNDER

Application No. 43362 Permit No. 32408
IN NAME OF

LARRY LIMBECK

Surveyed May 22 1974, by D. Norby