


T.10&11S., R.1W., W.M.

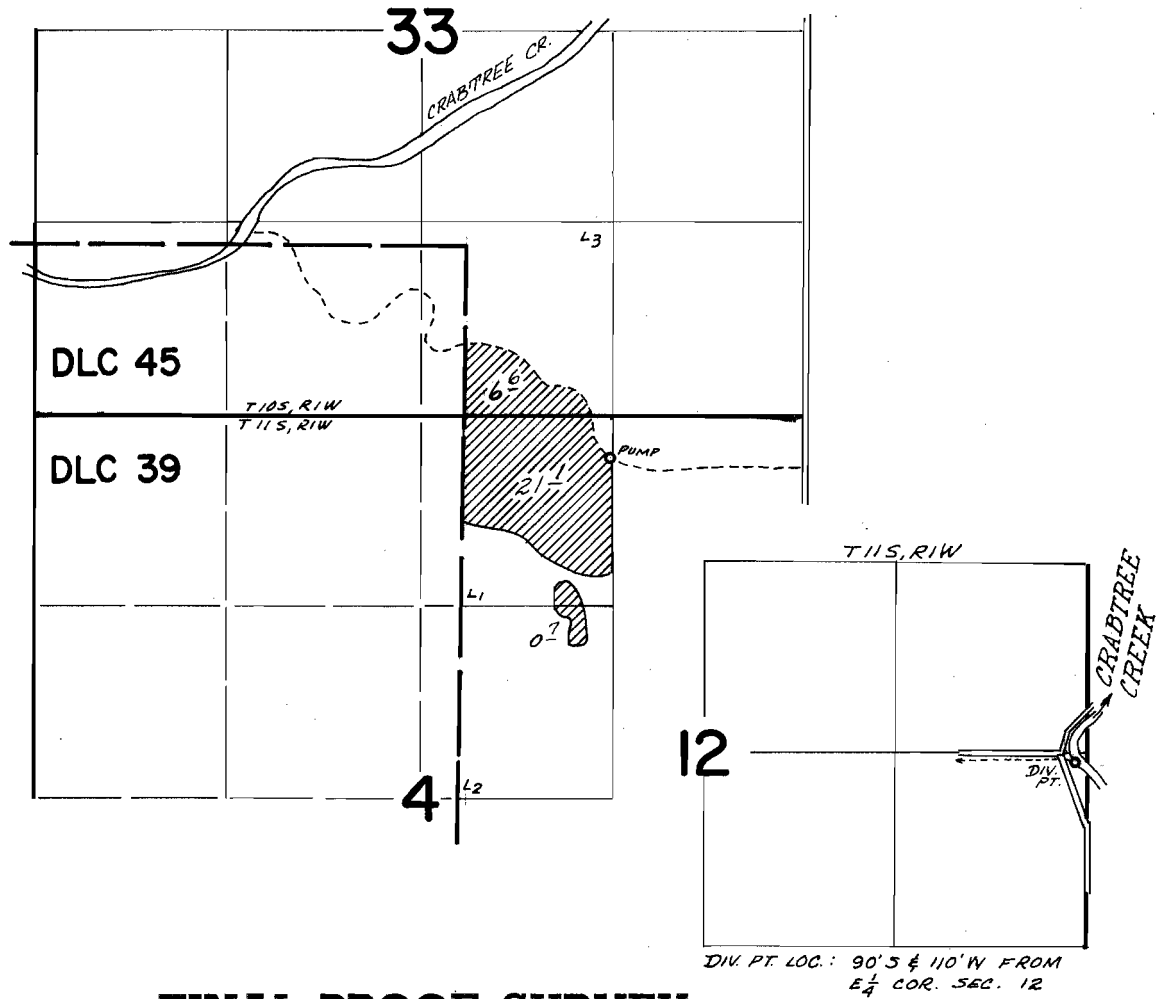

FINAL PROOF SURVEY UNDER

Application No. 43475 Permit No. 32518
IN NAME OF

CHARLES AND ETHEL SPIKER

Surveyed May 21 1974, by D. Norby