


T. 13S. R. 2E. W.M.

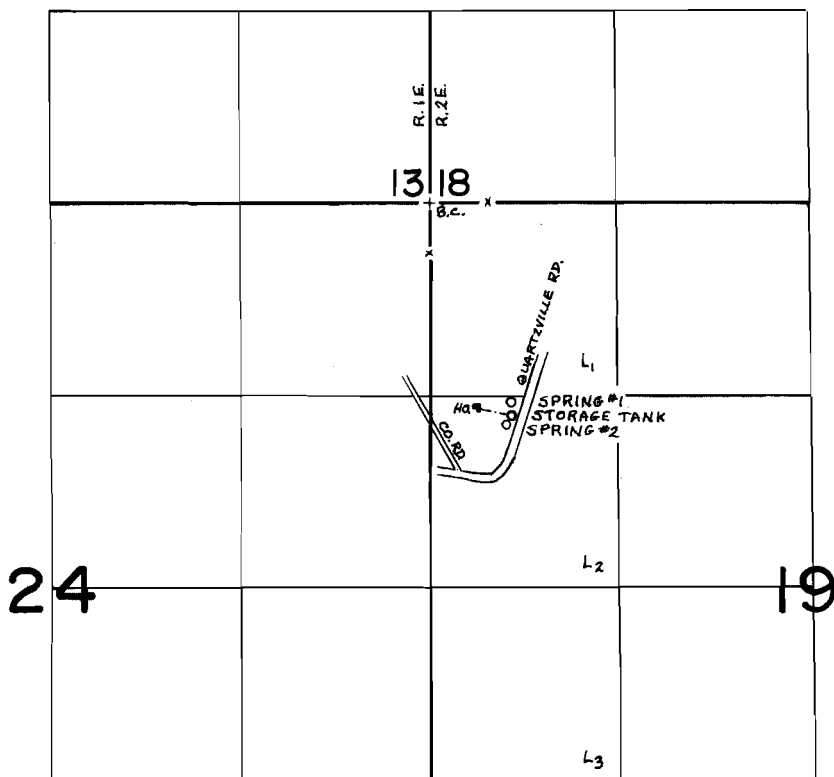

SPRINGS LOCATED: #1 - 1360'S. & 550'E.; #2 - 1530'S. & 520'E.
BOTH FROM NW COR SEC 19

FINAL PROOF SURVEY UNDER

Application No. 44402 Permit No. 33165
IN NAME OF

GEORGE A. & JENNIE L. MEALY

Surveyed OCT. 15 1974, by D. NORBY