


# T. 12S. R. 1W. W.M.

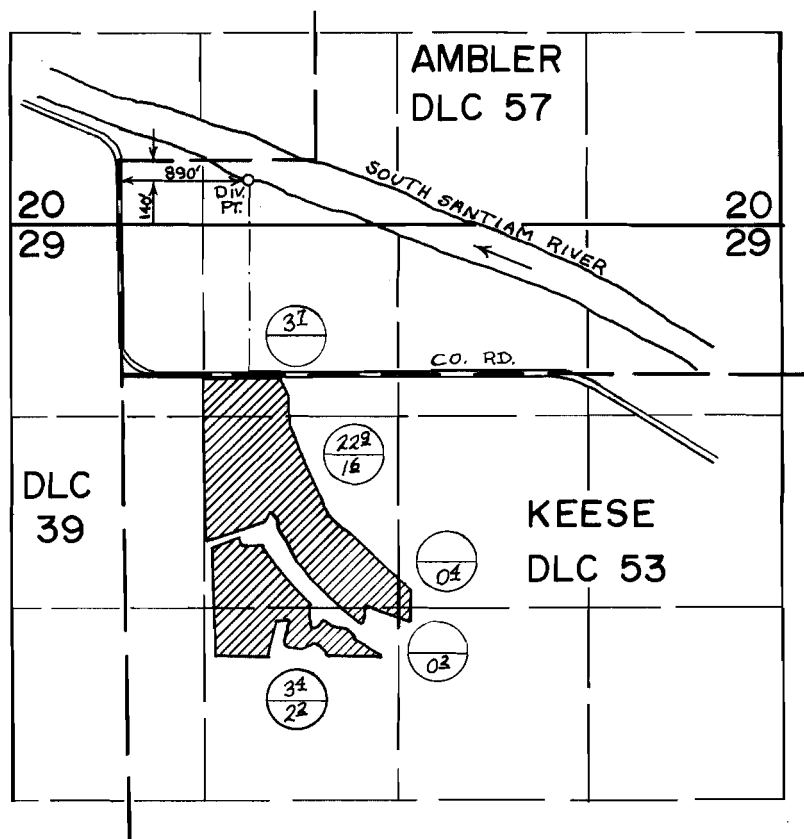

— CERTIFICATE #23612  
— PERMIT #33166

## FINAL PROOF SURVEY UNDER

Application No. 44403 Permit No. 33166  
IN NAME OF

THOMAS & ROSEMARY C. BARRETO

Surveyed MAY 24 1974, by D. NORBY