


T.I.S., R.I.E., W.M.

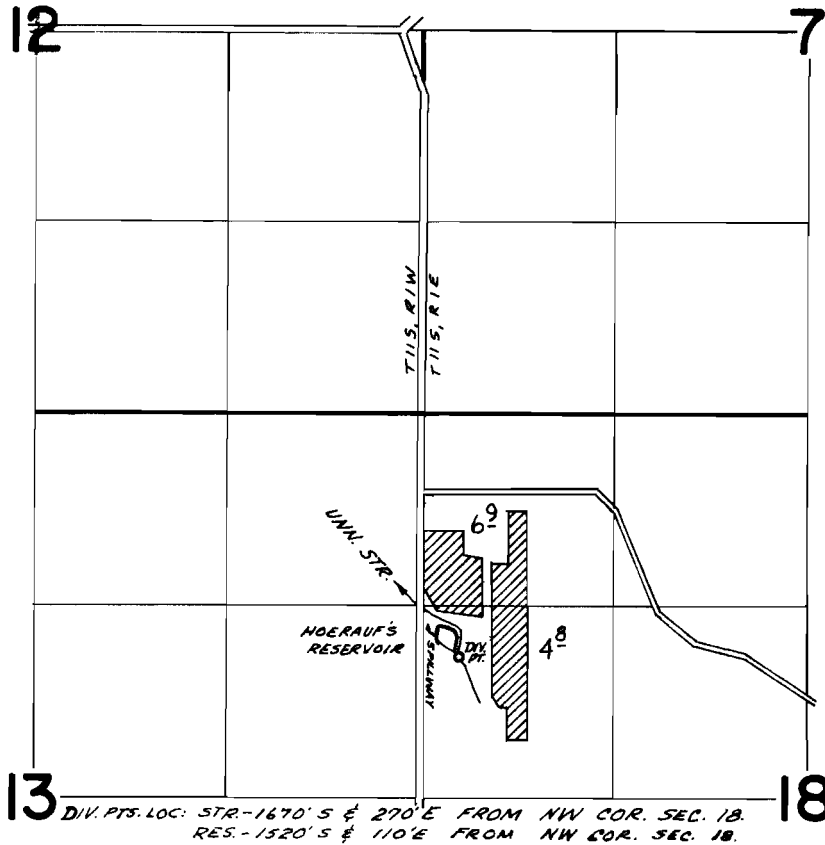

FINAL PROOF SURVEY UNDER

R-45301 R-5345
Application No. 45302 Permit No. 33824
IN NAME OF

EMIL AND IRENE HOERAUF

Surveyed May 20 1974, by D.M. Norby