


# T.IIS., R.I.E., W.M.

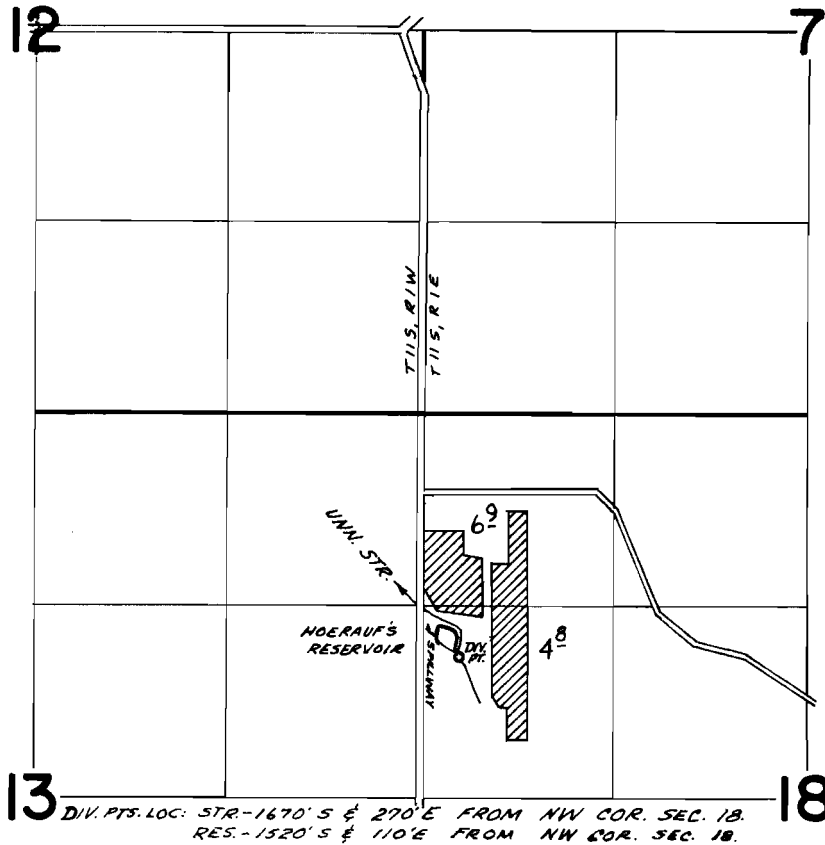

## FINAL PROOF SURVEY UNDER

R-45301                      R-5345  
Application No. 45302    Permit No. 33824  
IN NAME OF

EMIL AND IRENE HOERAUF

Surveyed May 20 1974, by D.M. Norby