


T.9S., R.3E., W.M.

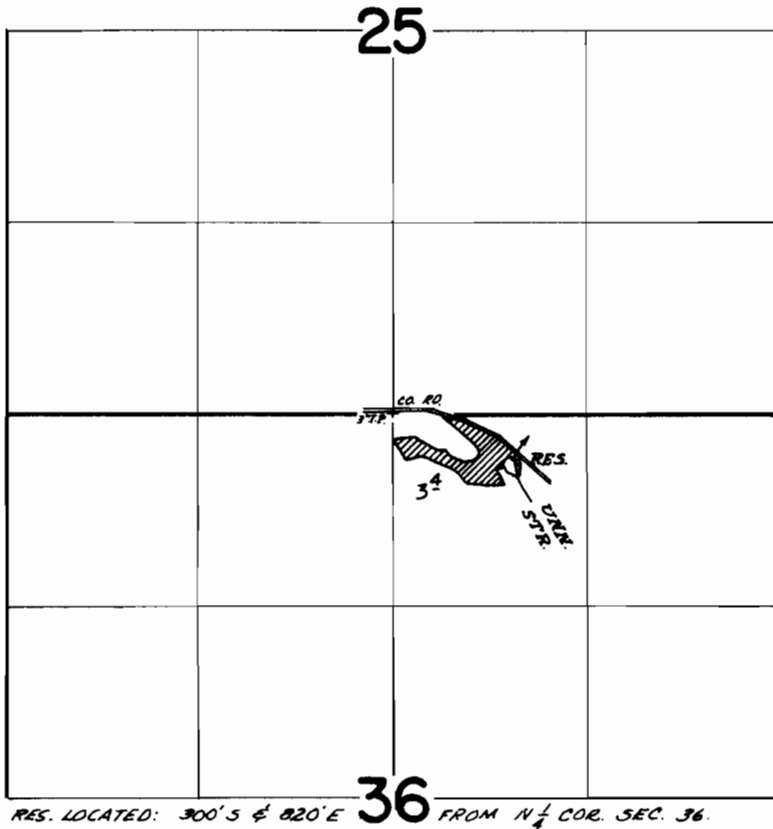

**FINAL PROOF SURVEY**  
UNDER

**R-45691**                      **R-5412**  
Application No. **45692** Permit No. **34087**  
IN NAME OF

**JAMES D. AND MYRTLE K. DONAHUE**

Surveyed **April 29** 19**74**, by **D. Norby**