


T.9S., R.3E., W.M.

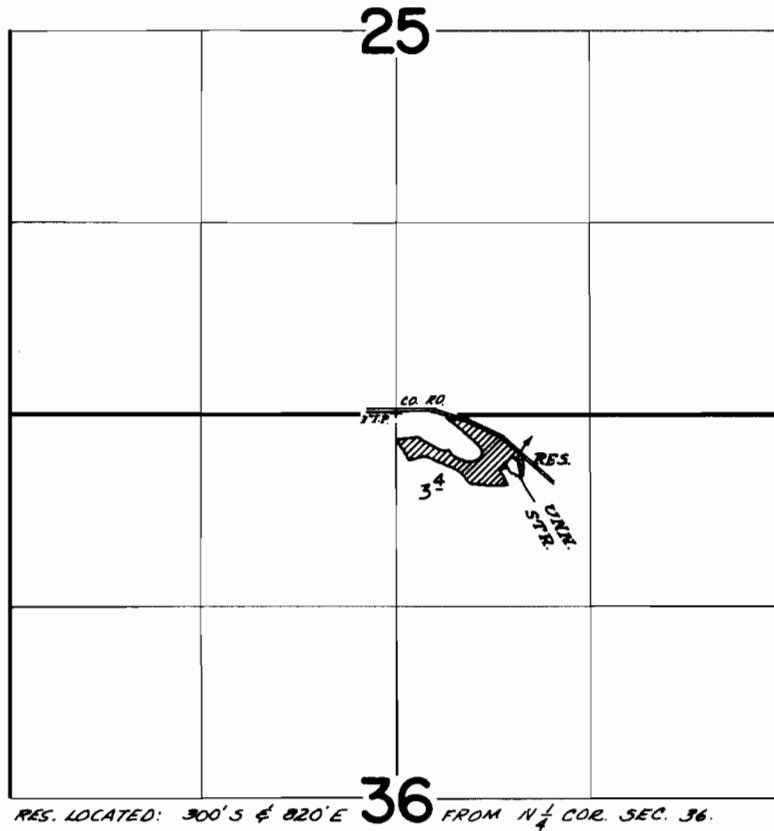

FINAL PROOF SURVEY
UNDER

R-45691 R-5412
Application No. 45692 Permit No. 34087
IN NAME OF

JAMES D. AND MYRTLE K. DONAHUE

Surveyed April 29 1974, by D. Norby