


T.12S., R.1E., W.M.

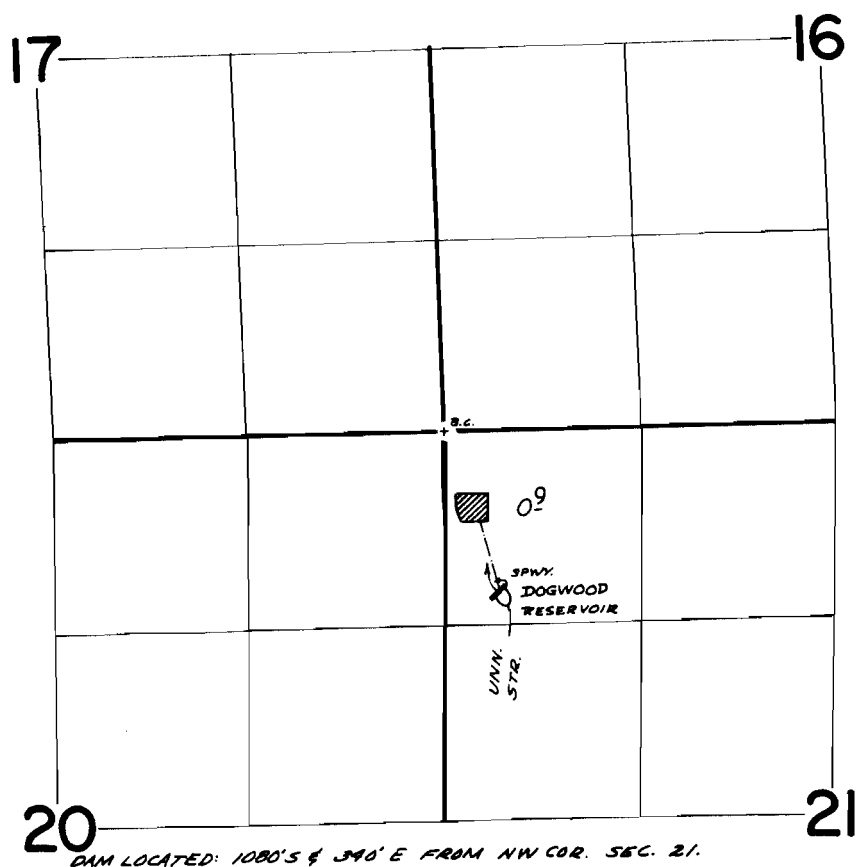

FINAL PROOF SURVEY
UNDER

R-45951 R-5465
Application No. 45952 Permit No. 34325
IN NAME OF
MARION A. AND CORALEE M. BAILEY
Surveyed May 23 1974, by D.M. Norby