


T.12S., R.1W., W.M.

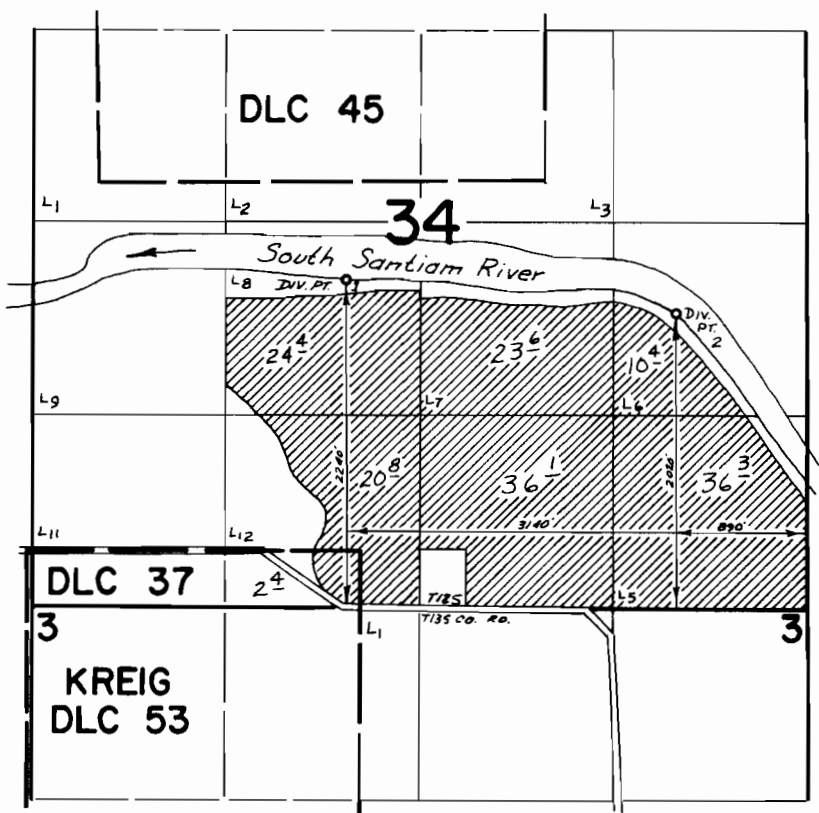

FINAL PROOF SURVEY
UNDER

Application No. 46571 Permit No. 34806
IN NAME OF

HELMS BROTHERS AND JIM TOWERY

Surveyed May 24 1974, by D.M. Norby