


T.16S. R.4W. W.M.

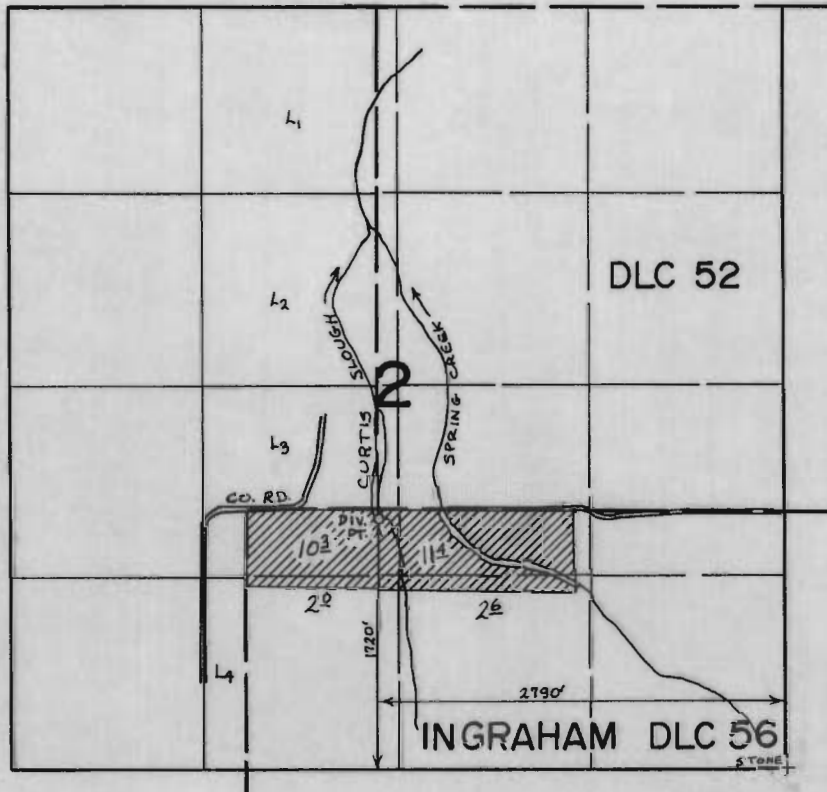

FINAL PROOF SURVEY  
UNDER

Application No. 48096 Permit No. 36119  
IN NAME OF

JOHN W. & PATRICIA I. HAYWORTH

Surveyed AUG. 7 1974, by D. NORBY