


T.9S., R.3E., W.M.

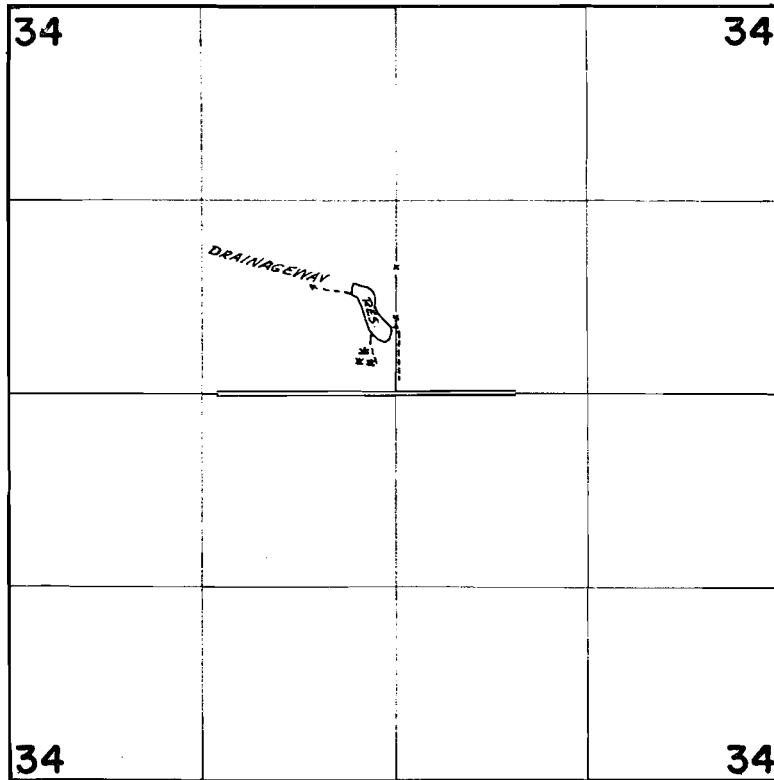

RES. LOCATED: 680' N & 300' W FROM CENTER SECTION 34

FINAL PROOF SURVEY
UNDER

R-48733 R-5912
Application No. 48734 Permit No. 36556
IN NAME OF

FRANK. R. FOLEY

Surveyed April 29, 1974, by D. Norby