


T.10S., R.2W., W.M.

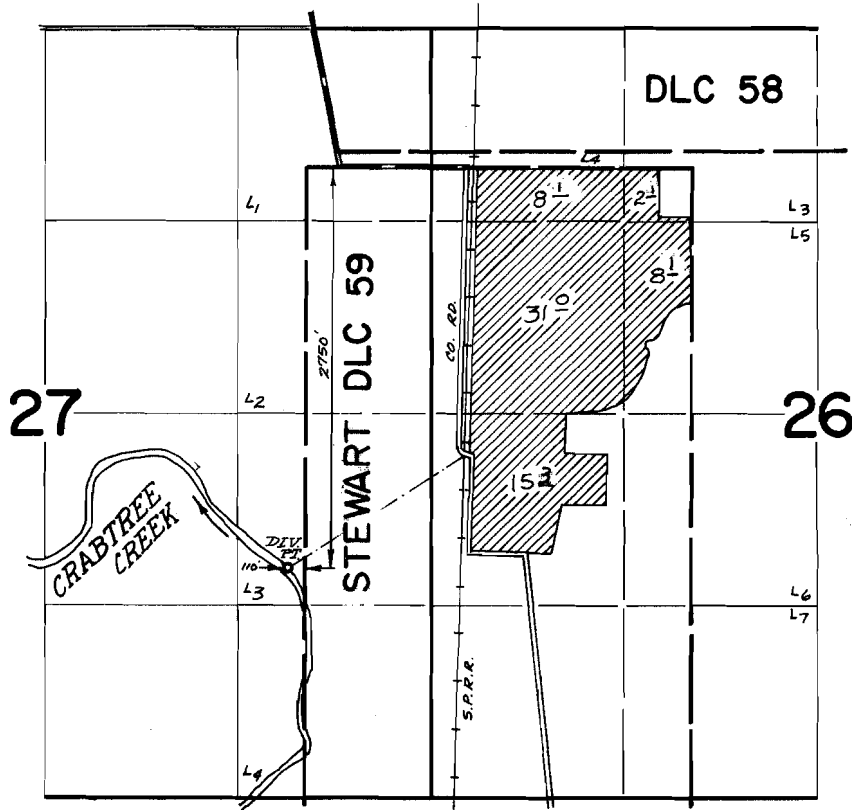

FINAL PROOF SURVEY
UNDER

Application No. 50784 Permit No. 36958
IN NAME OF

DANIEL L. AND KATHLEEN S. SPOOR

Surveyed Oct. 17, 1974, by D. Norby