


T.5S. R.2W. W.M.

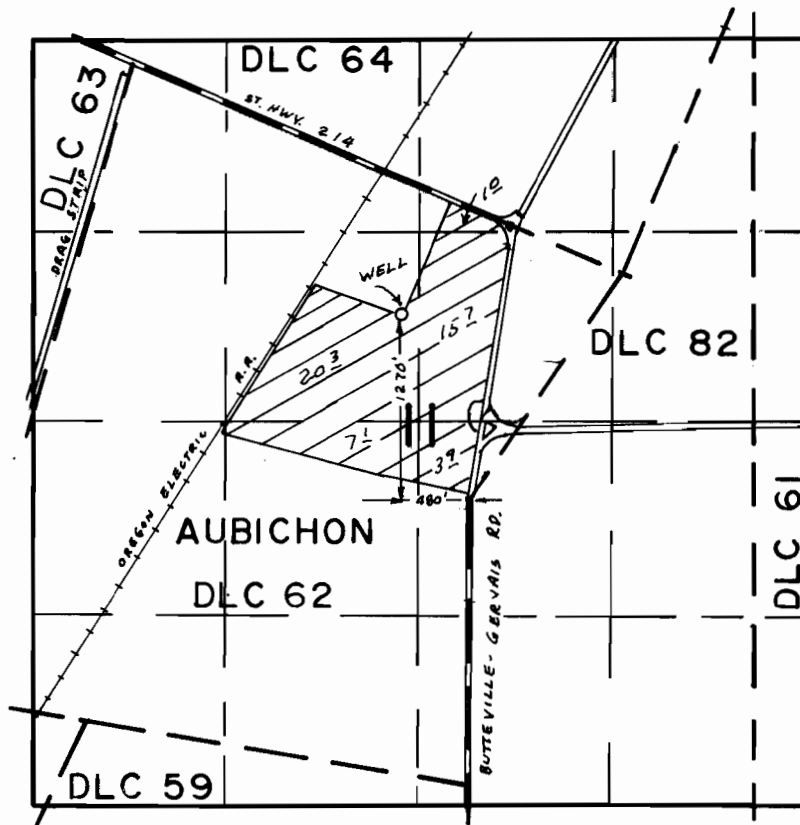

**FINAL PROOF SURVEY**  
UNDER

Application No. G-3755 Permit No. G-3545  
IN NAME OF

PATRICK McCORMICK

Surveyed SEP 3 1974, by L.H. NUNN