


T.3S. R.1W. W.M.

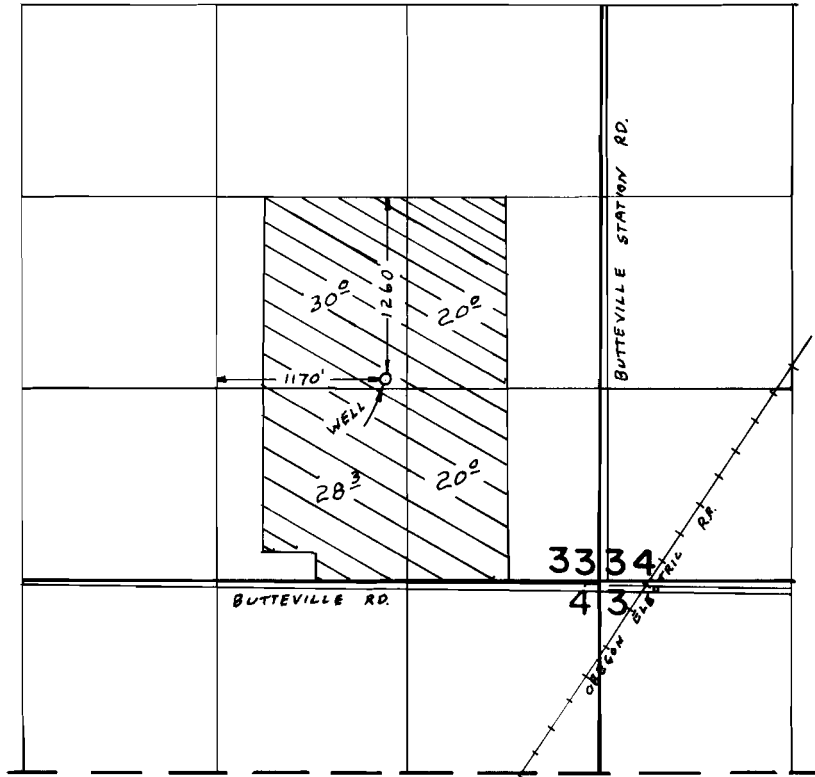

FINAL PROOF SURVEY UNDER

Application No. G-4173 Permit No. G-3922
IN NAME OF

EDWARD M. SHANNON

Surveyed MAY 23 1974, by L.H. NUNN