


T.9S. R.2W. W.M.

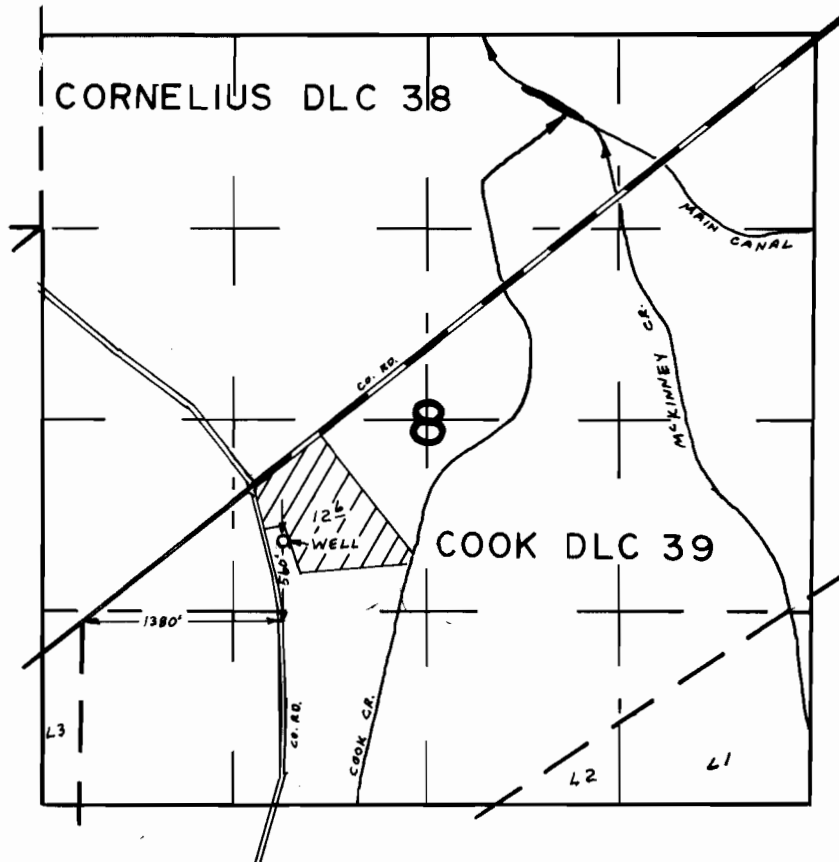

**FINAL PROOF SURVEY**  
UNDER

Application No. G-4583 Permit No. G-4312  
IN NAME OF

ALVA G. & MARY L. DAVIS

Surveyed JUL 3 1974, by L.H. NUNN