


T.7S. R.18&2W. W.M.

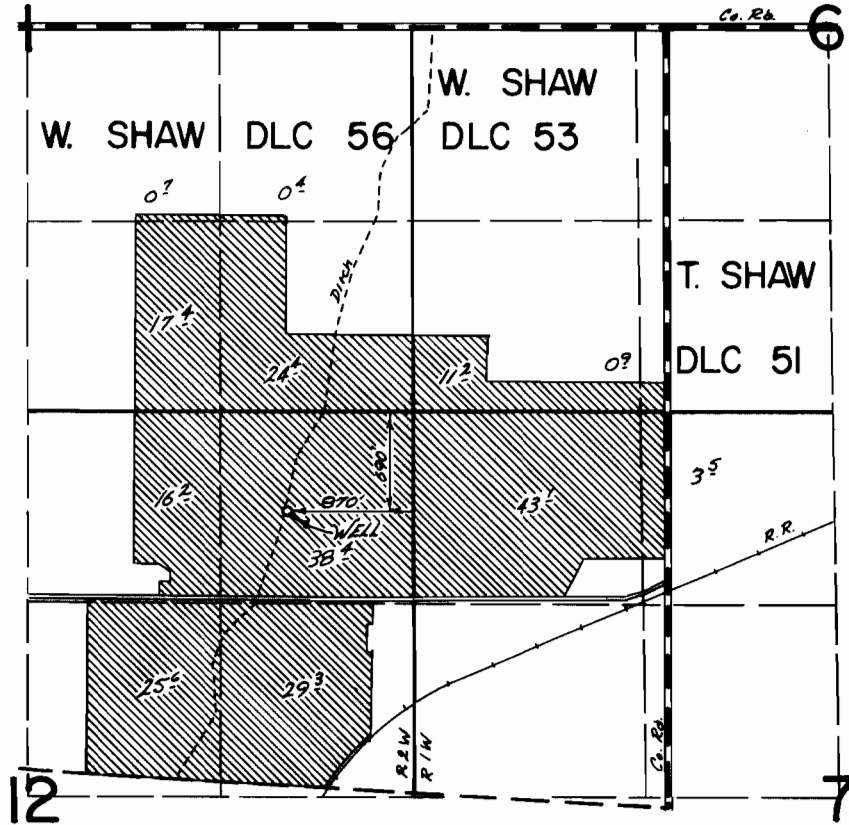

FINAL PROOF SURVEY UNDER

Application No. G-4697. Permit No. G-4415.
IN NAME OF

CLIFFORD HERR

Surveyed April 9, 1974, by T. J. PAUL